




ATTACHMENT 1

Ambulance Line Drawings & Specifications

Care Ambulance 2016

96" X 148" HEV Module on Ford E350 138" WB chassis, 72" Headroom

ALL EMERGENCY LIGHTS TO BE PROGRAMMED TO TRIPLE FLASH

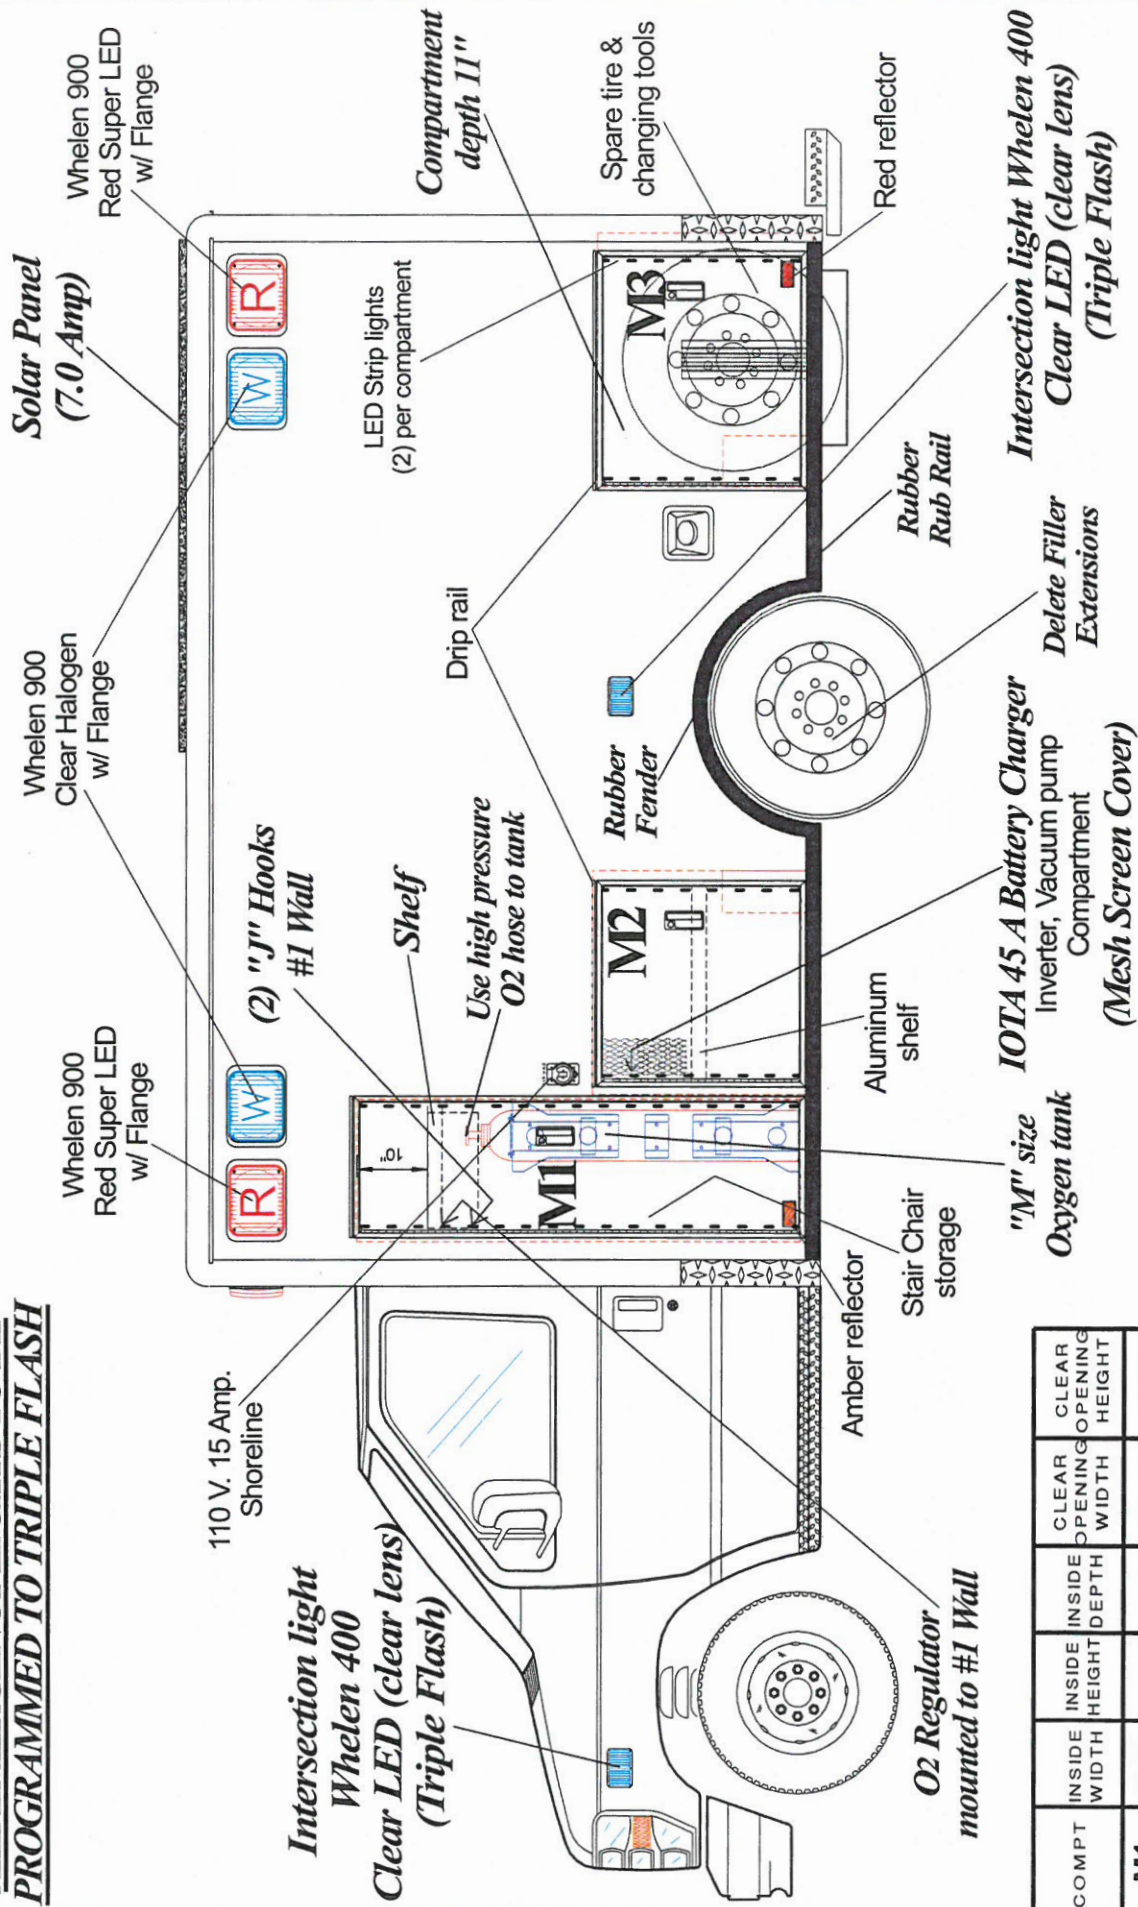

110 V. 15 Amp. Shoreline

COMPT	INSIDE WIDTH	INSIDE HEIGHT	INSIDE DEPTH	CLEAR OPENING WIDTH	CLEAR OPENING HEIGHT
M1	19.75	61.50	20.375	16.75	60.625
M2	31.125	29.625	20.375	25.75	26.375
M3	34.625	29.625	II	30.125	26.375

Note: All dimensions are approximate and subject to change.

VIEW: Streetside Exterior

Drawn By: Jorge M.

Date: March - 2016


LE- 1



Care Ambulance 2016

96" X 148" HEV Module on Ford E350 138" WB chassis, 72" Headroom

ALL EMERGENCY LIGHTS TO BE PROGRAMMED TO TRIPLE FLASH

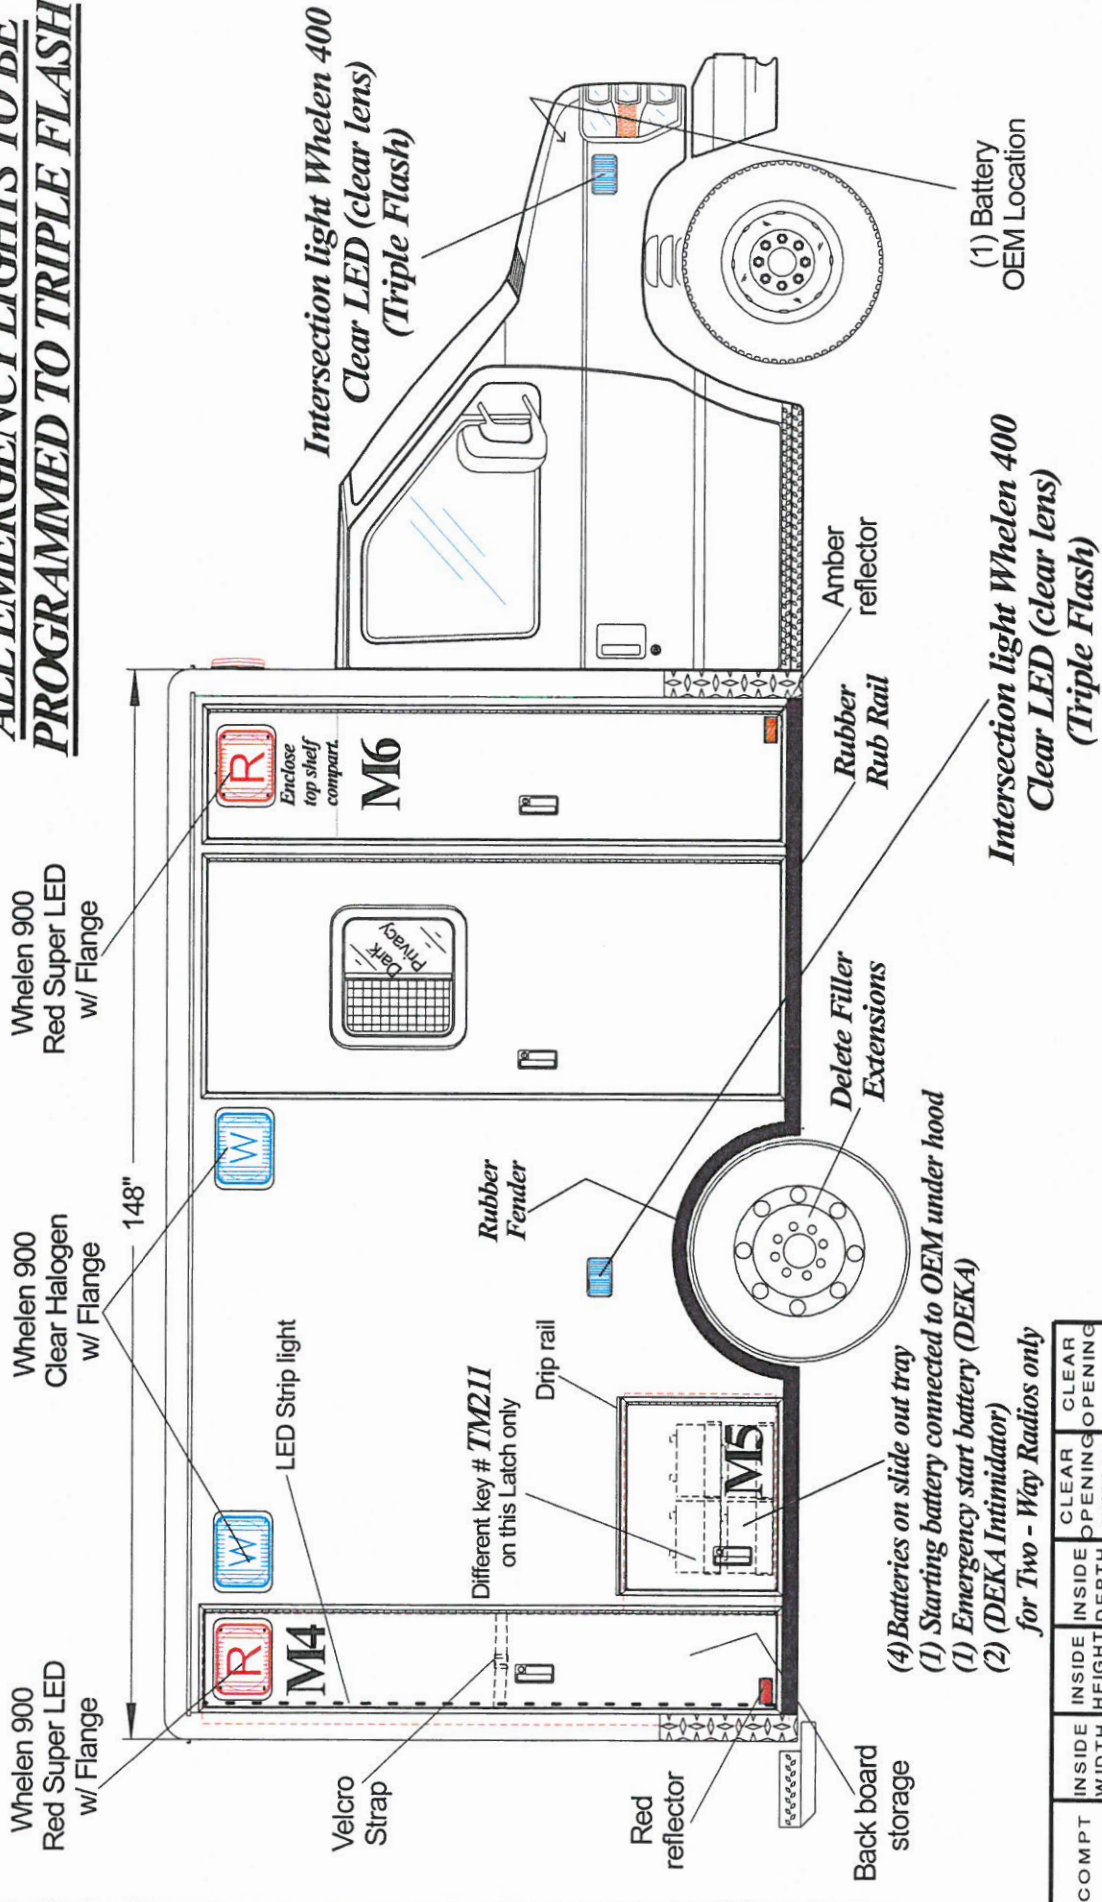

- (4) Batteries on slide out tray
 - (1) Starting battery connected to OEM under hood
 - (1) Emergency start battery (DEKA)
 - (2) (DEKA Intimidator)
- for Two - Way Radios only

COMPT	INSIDE WIDTH	INSIDE HEIGHT	INSIDE DEPTH	CLEAR OPENING WIDTH	CLEAR OPENING HEIGHT
M4	13.00	80.00	20.375	12.125	79.16
M5	31.875	20.625	16.50	24.625	20.125
M6				16.625	79.16

Note: All dimensions are approximate and subject to change.


VIEW: Curbside Exterior

Drawn By: Jorge M.


Date: March - 2016



LE- 2

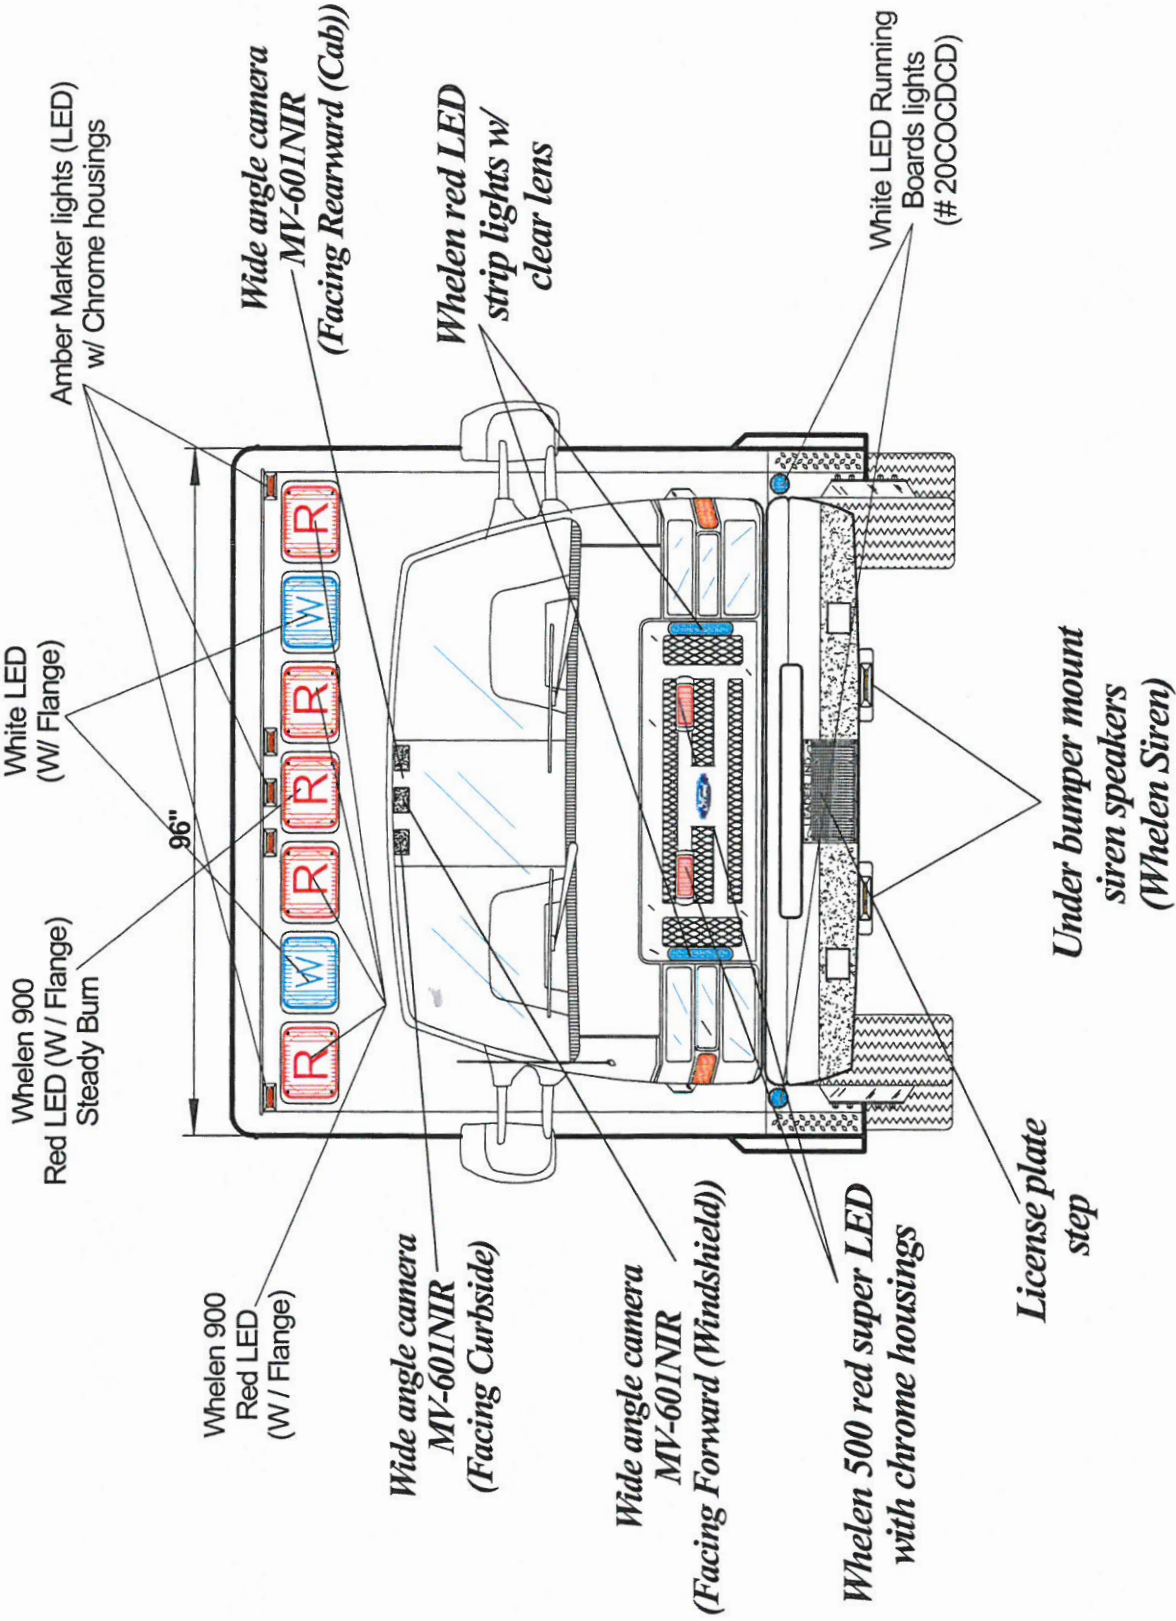

Note: All dimensions are approximate and subject to change.

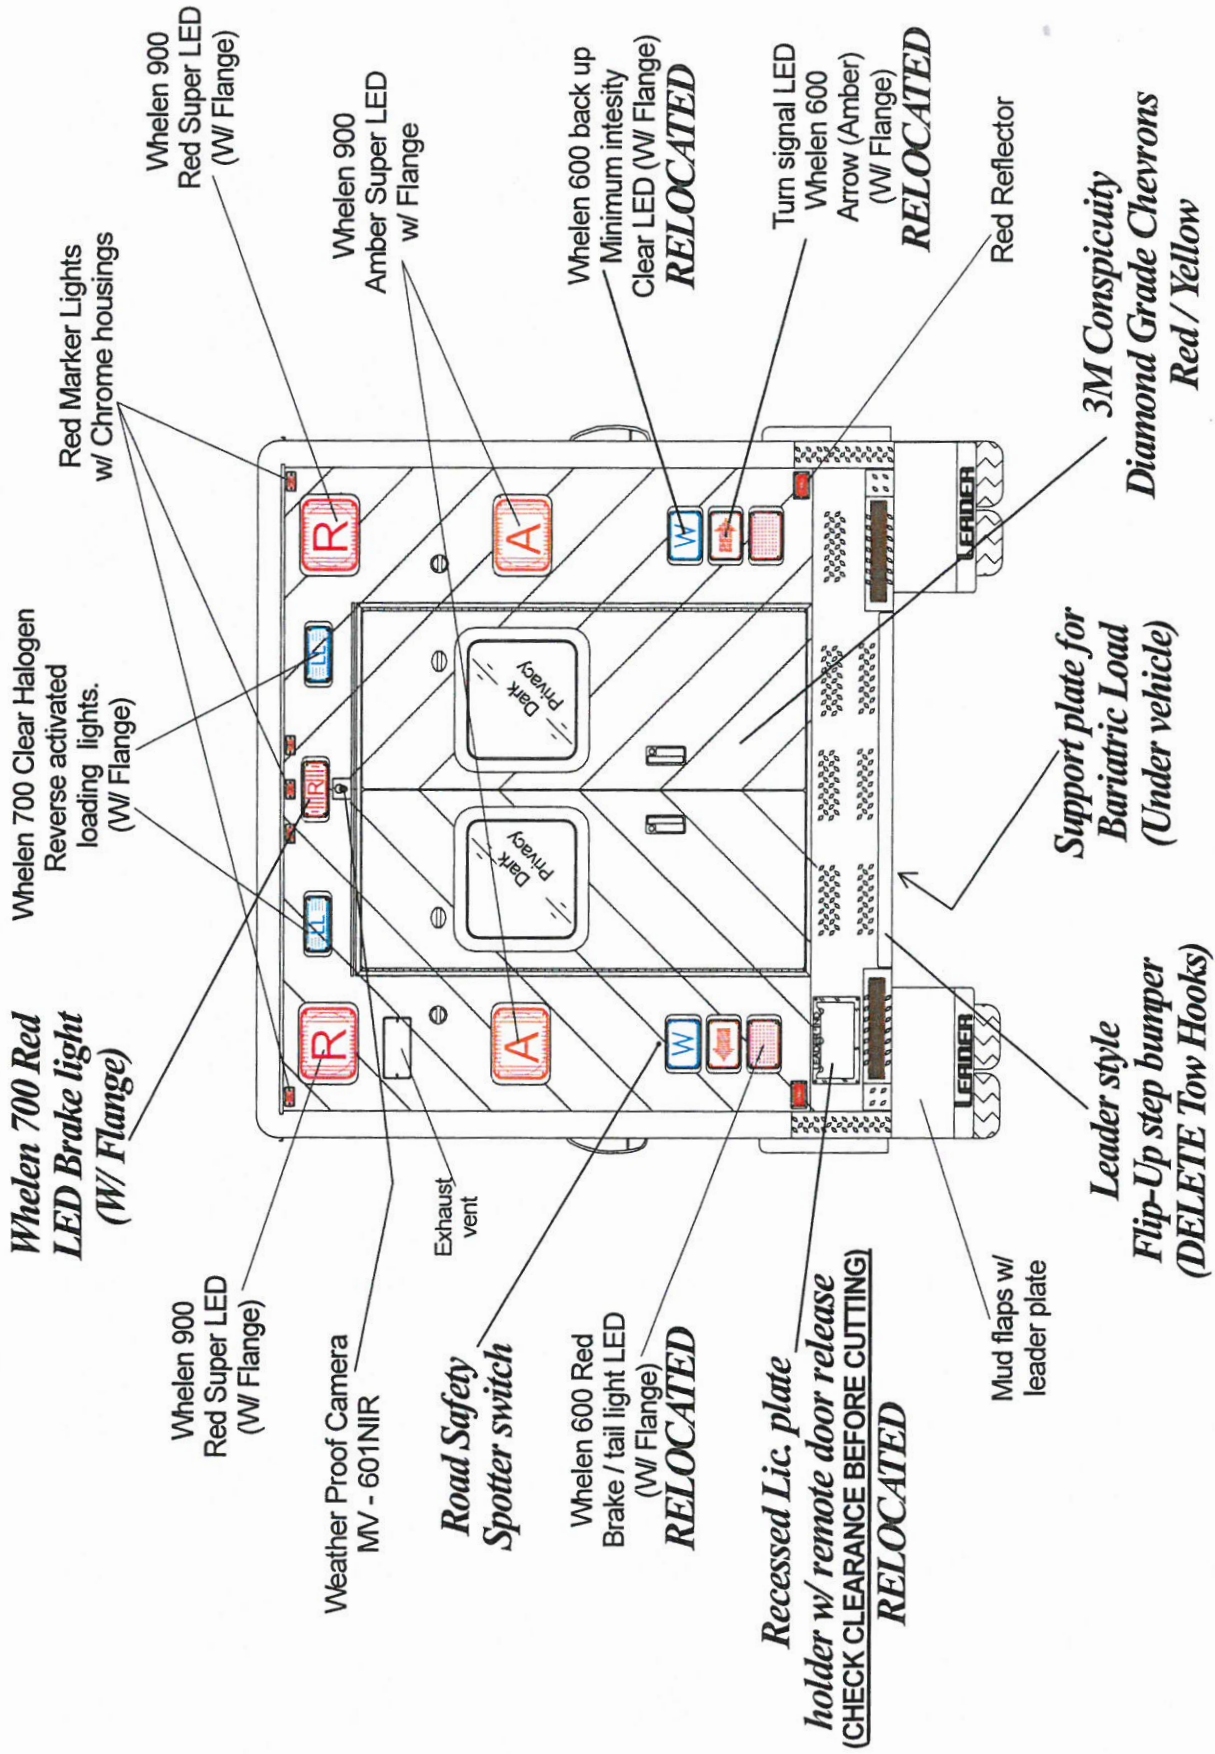

Note: All dimensions are approximate and subject to change.

Care Ambulance 2016

96" X 148" HEV Module on Ford E350 138" WB chassis, 72" Headroom

Cargo Net (Black)
w/ Mesh sewn on back
w/ Metal quick connect clips

~~DELETE Adjustable shelf~~
~~RELOCATE Drug Box~~


Ducted Central
A/C - Heat

A/C Intake

A/C Access

Enlarged
Oxygen access
Plexiglas door

Exhaust
Vent

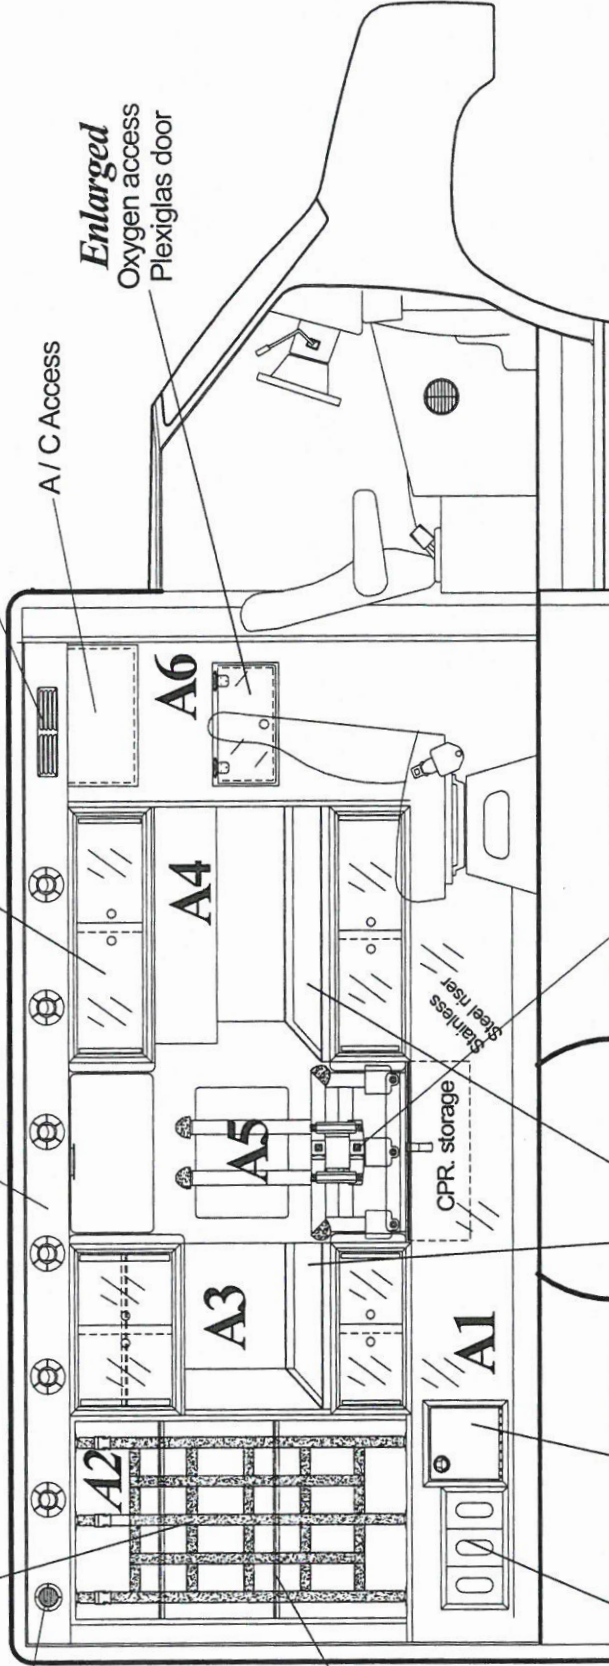

(2) Adjustable
shelves inside
compartment

Tip out
trash

(3) latex
glove storage
"SE" Style
(Gloves not included)

Stainless Steel
trays

6 - Point Seat
belt restraints

WHITE GLOSS LAMINATE

Note: All dimensions are approximate and subject to change.

VIEW: Street Side Interior

Drawn By: Jorge M.

Date: March - 2016

LE- 5



(Scanner Storage)
Fixed Top shelf (DELETE Lip)
Leave 17" opening and
enclose side access from
exterior compartment door

Terminal Strip
Two - Way Radio power only
(Label as Two - way
Radio Hook up only)

Leave enough space
for GPS Logic 5000 modem
(Approx. 12" X 12")

CARE Logo
Embroidered into
Seat Back



Attendant seat
w/ 3 point seatbelt
w/ built in childseat
Non swivel base

Access to Power
distribution
w/ locking latch

(2) "Puck" lights
Ign. Activated

Pre-wire
12 V. Rd/Bk

Pre-wire
CAT5

110 V. outlet

LED Strip lighting


(3) Adjustable shelves
inside compartment

Cargo Net (Black)
w/ Mesh sewn on back
w/ Metal quick connect clips


Shorten
Hinged partition wood door
w/ plexiglas sliding windows
w/ Chrome "D" ring NON locking latch

(2) Aluminum drawers
w/ Aluminum laminated face
w/ Chrome "D" ring locking latches


Stainless
steel tray

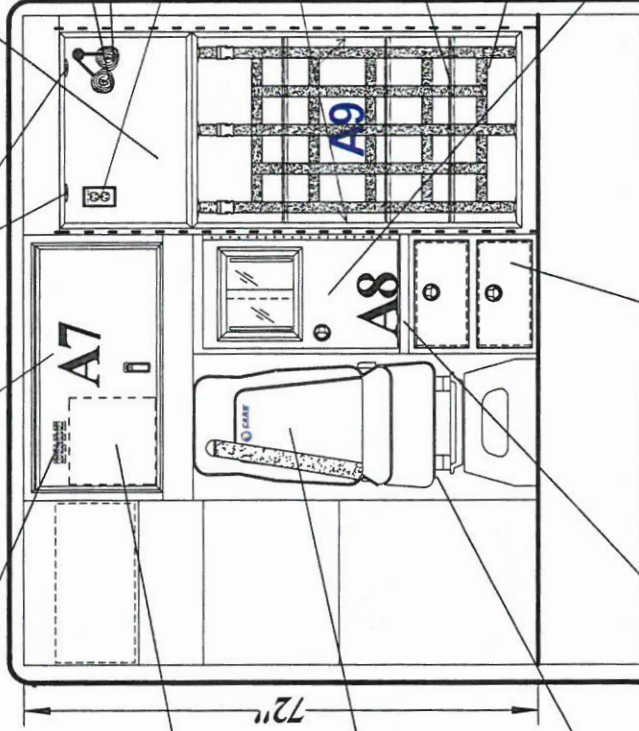


Note: All dimensions are approximate and subject to change.

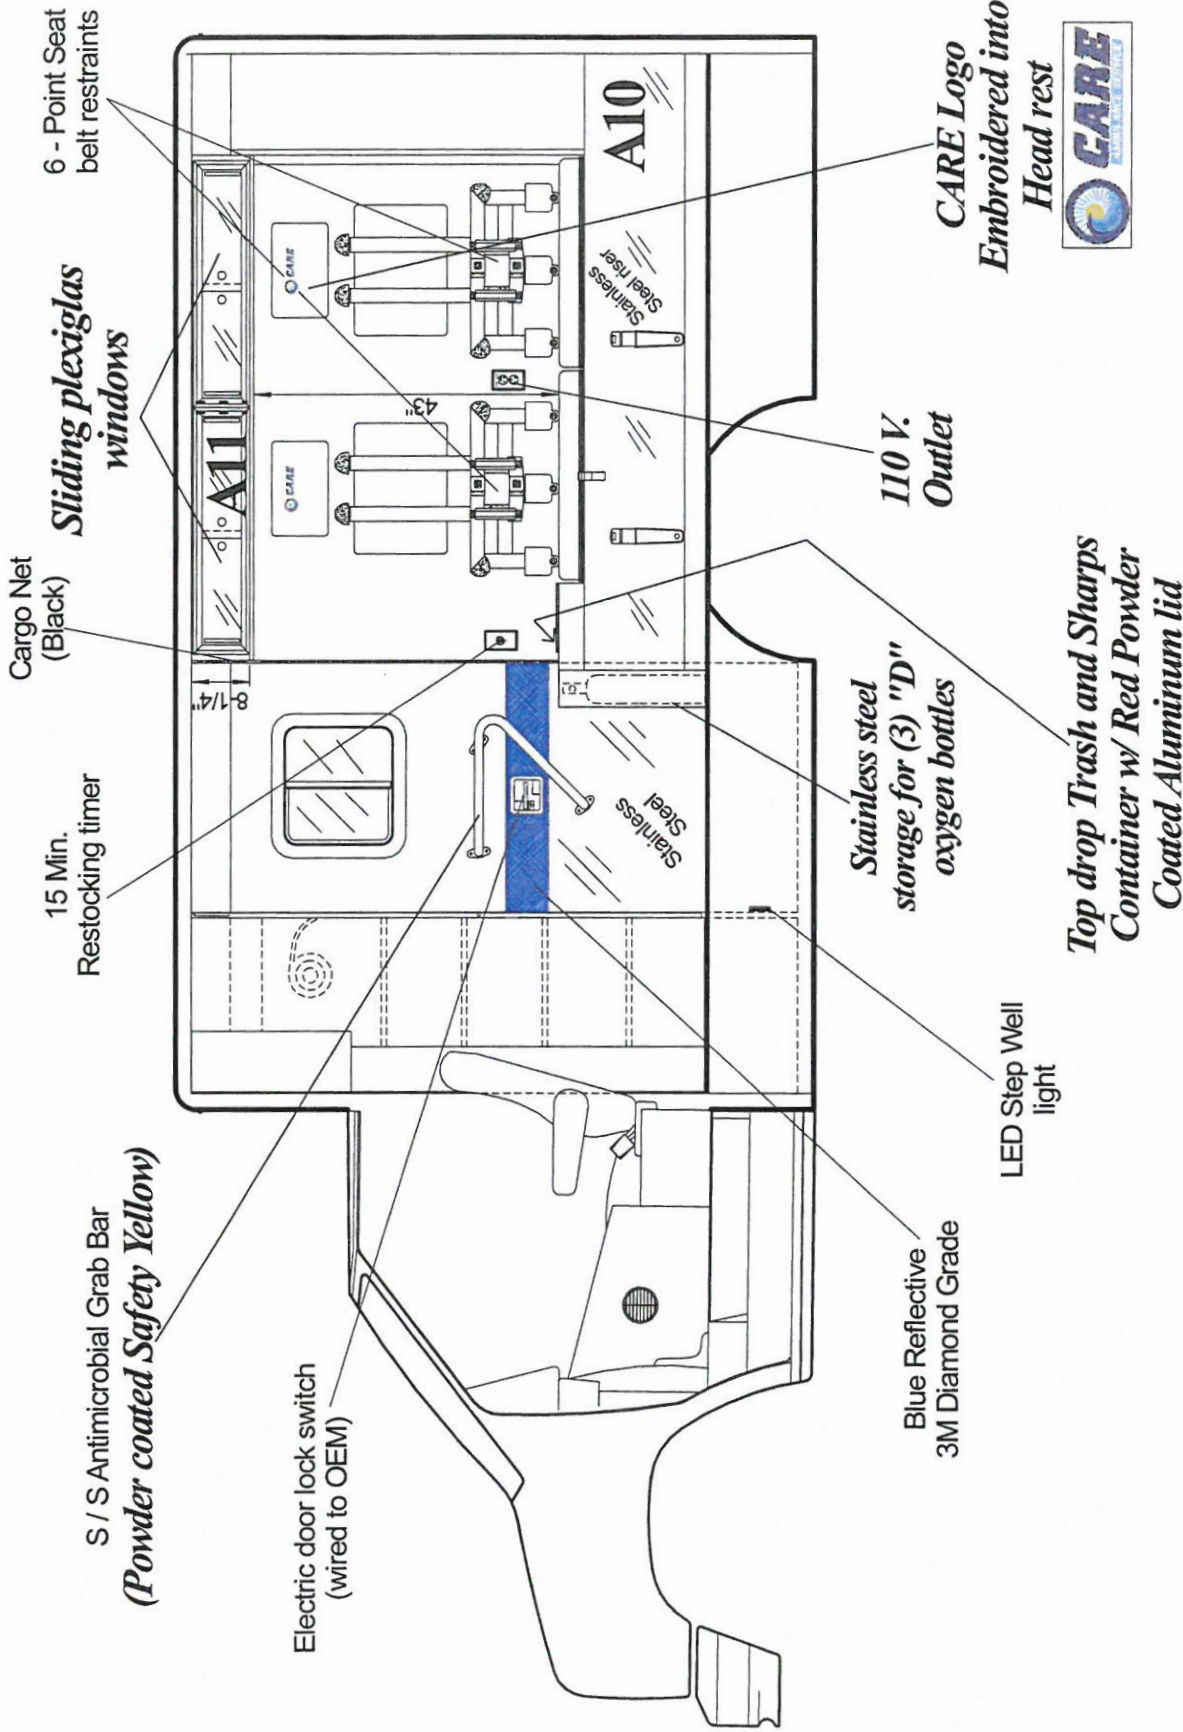

Note: All dimensions are approximate and subject to change.

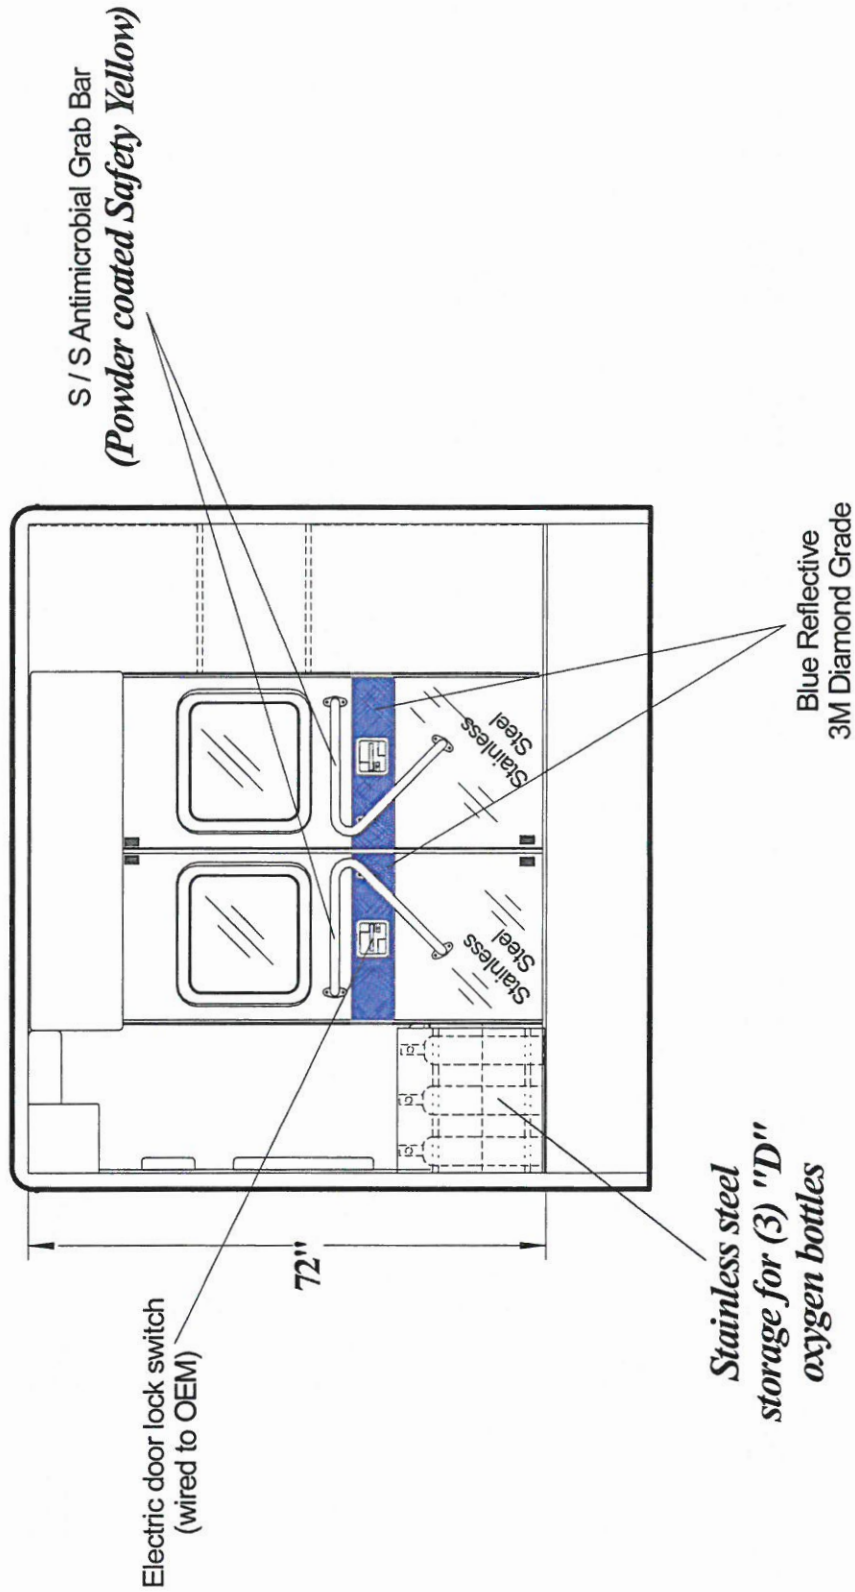

Note: All dimensions are approximate and subject to change.

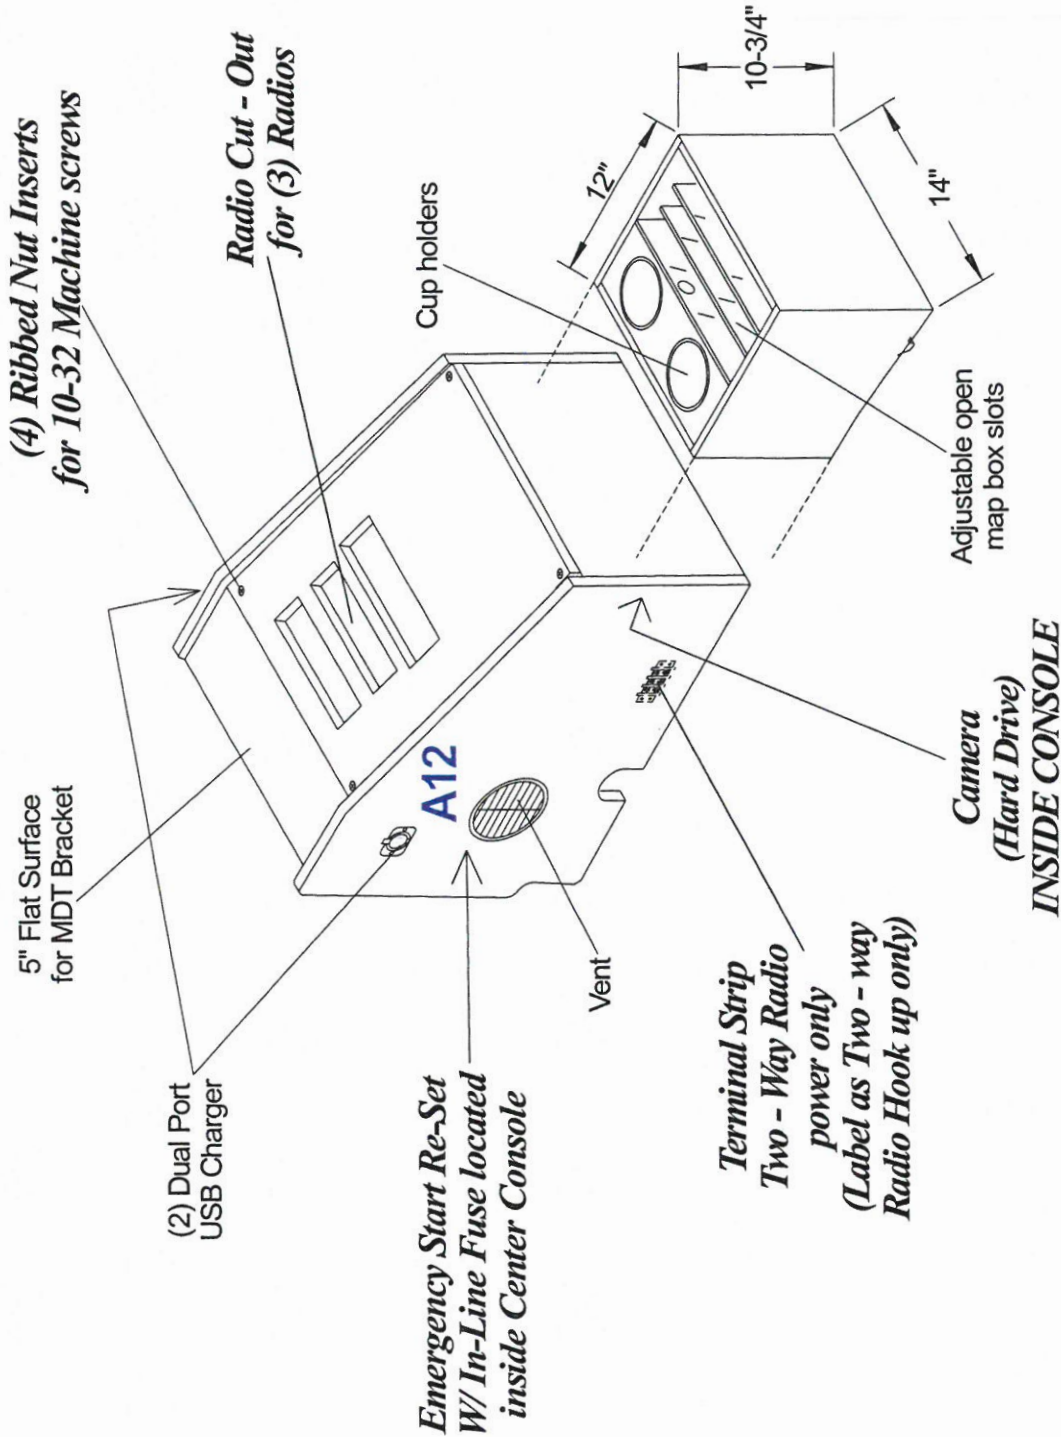

Note: All dimensions are approximate and subject to change.



Care Ambulance 2016


96" X 148" HEV Module on Ford E350 138" WB chassis, 72" Headroom

*Integrated Flowmeter
Annex 0-15 LPM
(Tube style)*

Oxygen
Outlet

Radio Cut-Out

*Drug box
compartment*

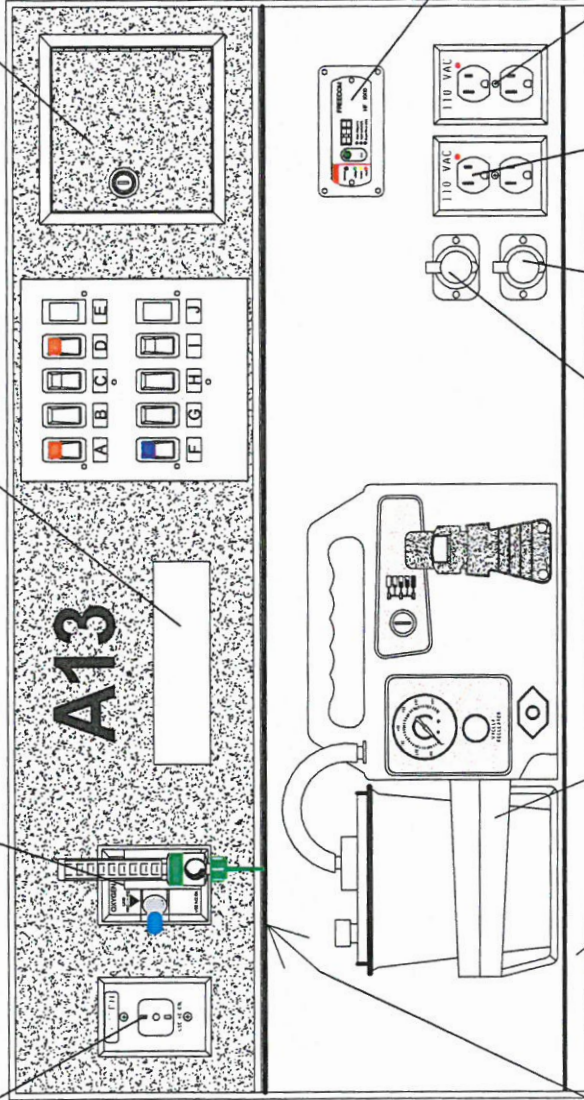

A= DOME ON 3-WAY - LIT AMBER LED
B= DOME HI/LO - ON / ON (NON LIT)

C= **WORK LIGHT - LIT WHITE LED**

D= EXHAUST VENT - LIT AMBER LED

E= BLANK

F= A/C ON 3-WAY - LIT BLUE LED

G= A/C FAN HI/LO - (NON LIT)

H= A/C HEAT/COOL - (NON LIT)

I= COMPARTMENTS LIGHTS - LIT WHITE LED

J= BLANK

*Xantrex Freedom
Remote Inverter panel*

12 V.
Outlet
Relocated

Dual port
USB Charger
Relocated

110 V.
Outlet
Relocated

*Additional
110 V.
Outlet*

Stainless Steel
tray

*Portable
SSCOR*

*LED Work
Light*

Note: All dimensions are approximate and subject to change.

VIEW: Switch Panel

Drawn By: Jorge M.

Date: March - 2016

LE-10




Care Ambulance 2016

96" X 148" HEV Module on Ford E350 138" WB chassis, 72" Headroom

*Customer Supplied
Stryker Power Load
Cot Fastener System*

*Move attendant seat as
close to wall as possible*

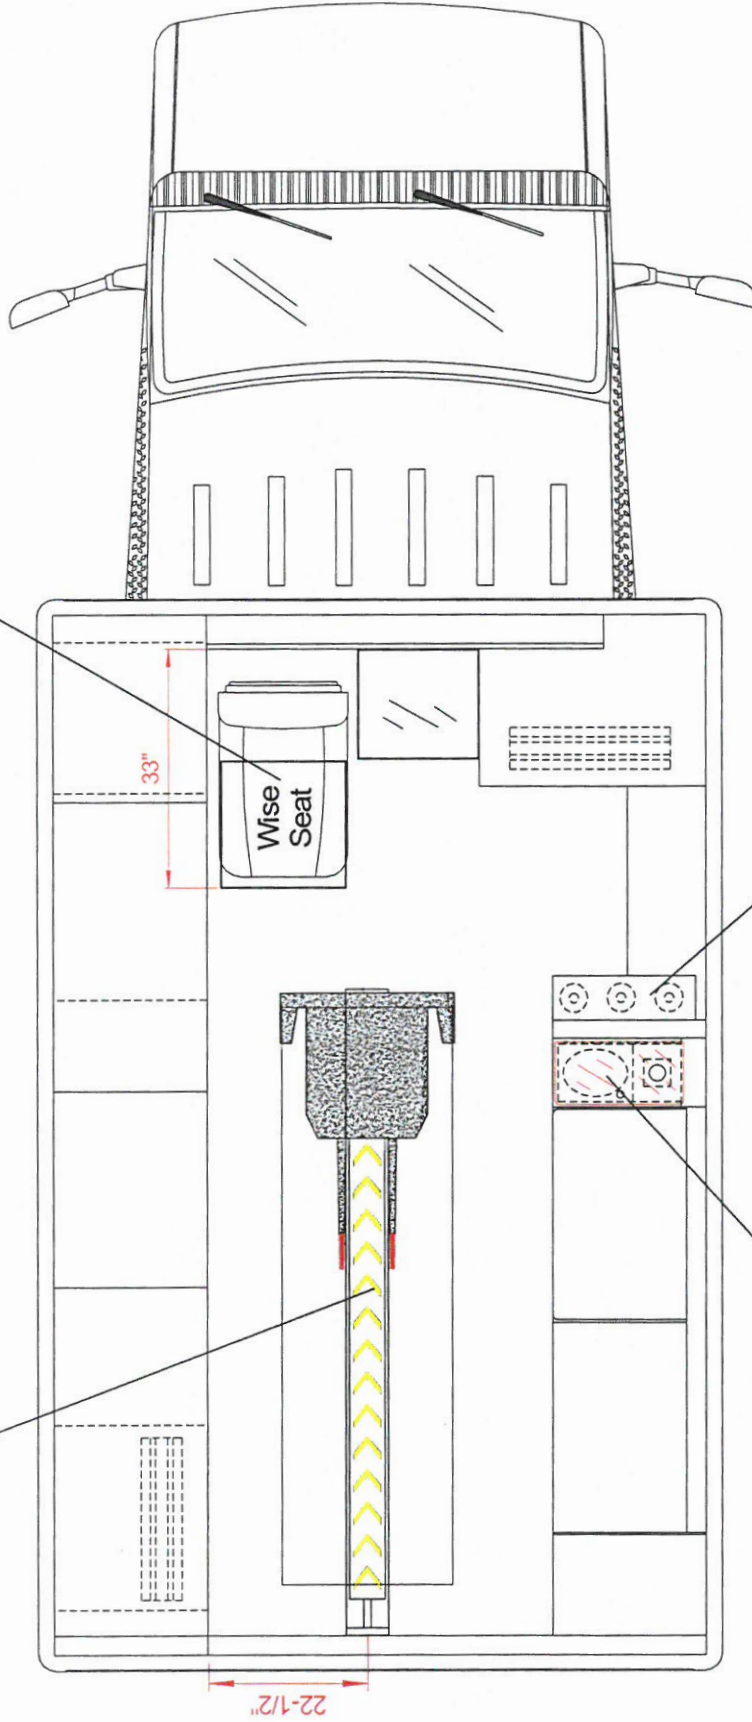

*Stainless steel
storage for (3) "D"
oxygen bottles*

*Top drop 1.7 Qt. sharps &
6 Qt. trash container
w/ Red Powder Coated lid
w/ Catch 2-way latch*

22-1/2"

33"

Note: All dimensions are approximate and subject to change.


VIEW: Overhead Floor

Drawn By: Jorge M.

Date: March - 2016


LE- 11



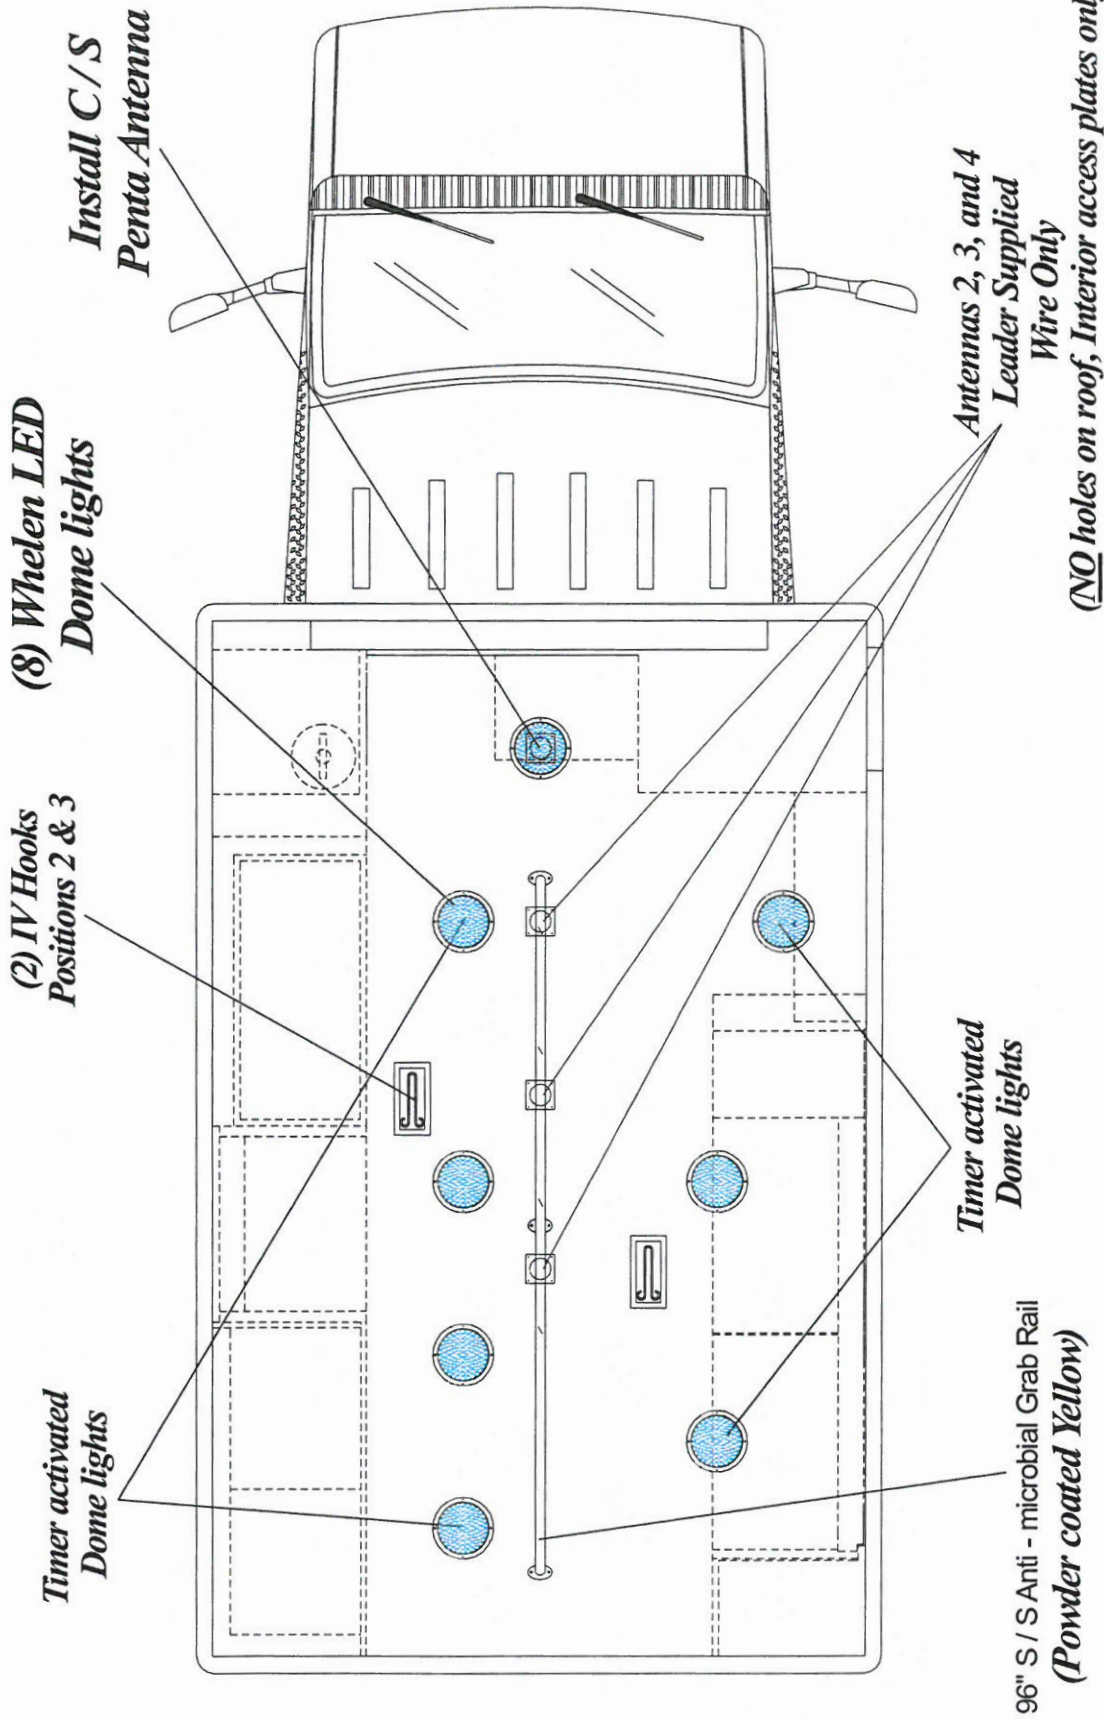

Note: All dimensions are approximate and subject to change.

Map lights
Red / White LED

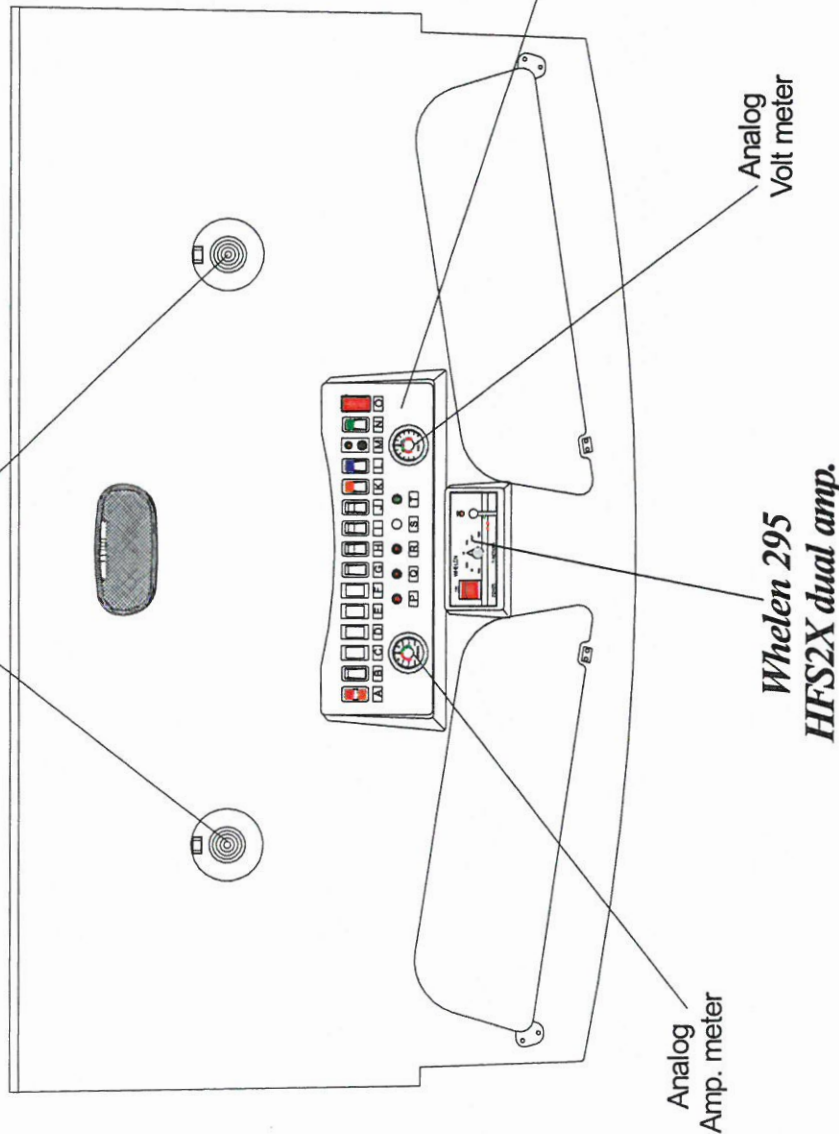

SWITCHES

A. PRI- SEC- LIT RED/ AMBER LED

NOTE: SIREN ACTIVATED

PRIMARY ONLY

B. HEAD LIGHT FLASER -LIT CLEAR LED

C. BLANK

D. BLANK

E. BLANK

F. BLANK

G. BACK UP ALARM-RESET TYPE-MOM. ON (NON LIT)

H. LEFT SCENE WHITE LIT LED

I. REAR SCENE WHITE LIT LED

J. RIGHT SCENE WHITE LIT LED

K. PATIENT DOME 3-WAY - LIT AMBER LED

L. PATIENT AC HEAT 3-WAY - LIT BLUE LED

M. ANTI - THEFT DEVICE

N. MOD. DISCONNECT - GREEN LIT LED

O. EMERGENCY START, ON-OFF GUARDED (NON LIT)

PILOT LIGHTS

O. PILOT LIGHT - PARKING BRAKE RED LED

P. PILOT LIGHT - DOOR OPEN RED LED

Q. PILOT LIGHT - EMERGENCY START RED LED

R. BLANK

S. PILOT LIGHT - MASTER ON GREEN LED


Carbon Fiber
finish

Analog
Amp. meter


Analog
Volt meter

**Whelen 295
HFS2X dual amp.**

Note: All dimensions are approximate and subject to change.

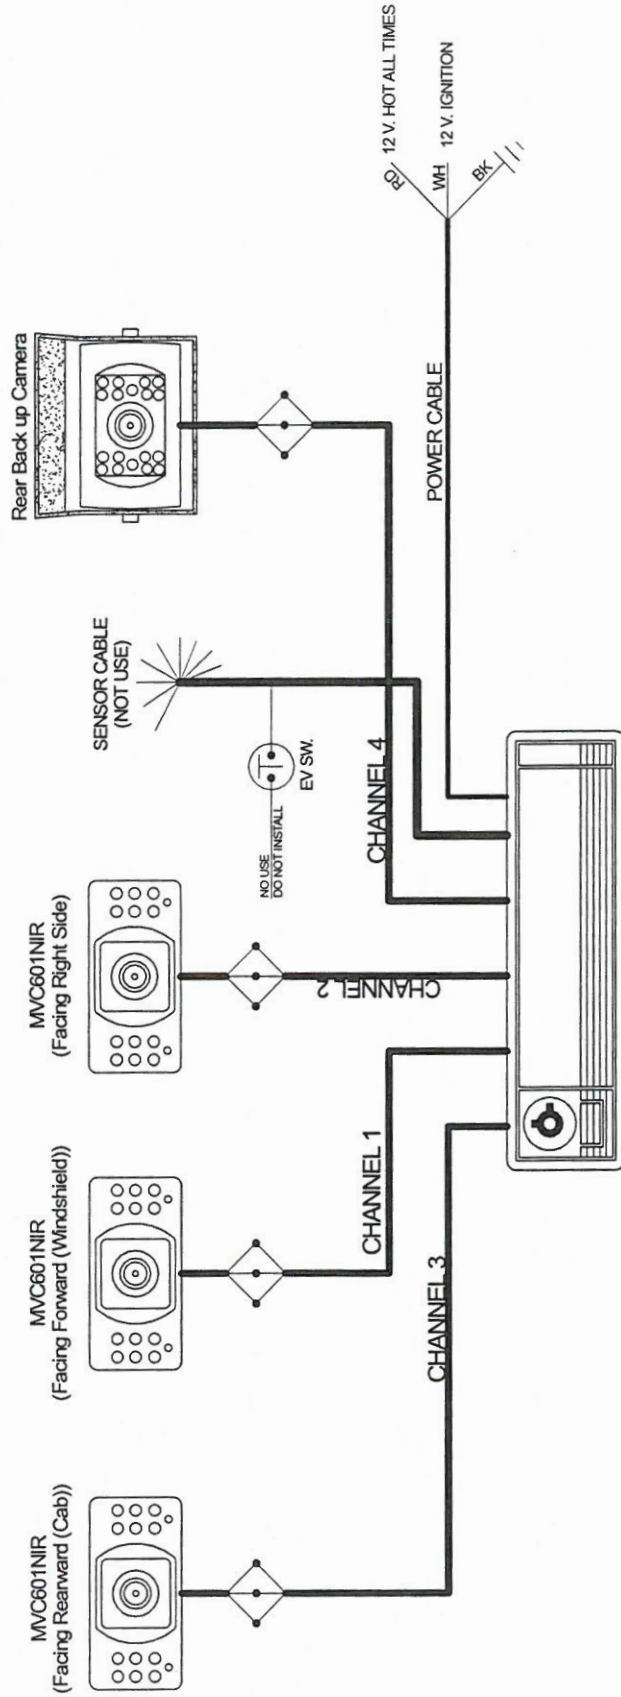

Note: All dimensions are approximate and subject to change.

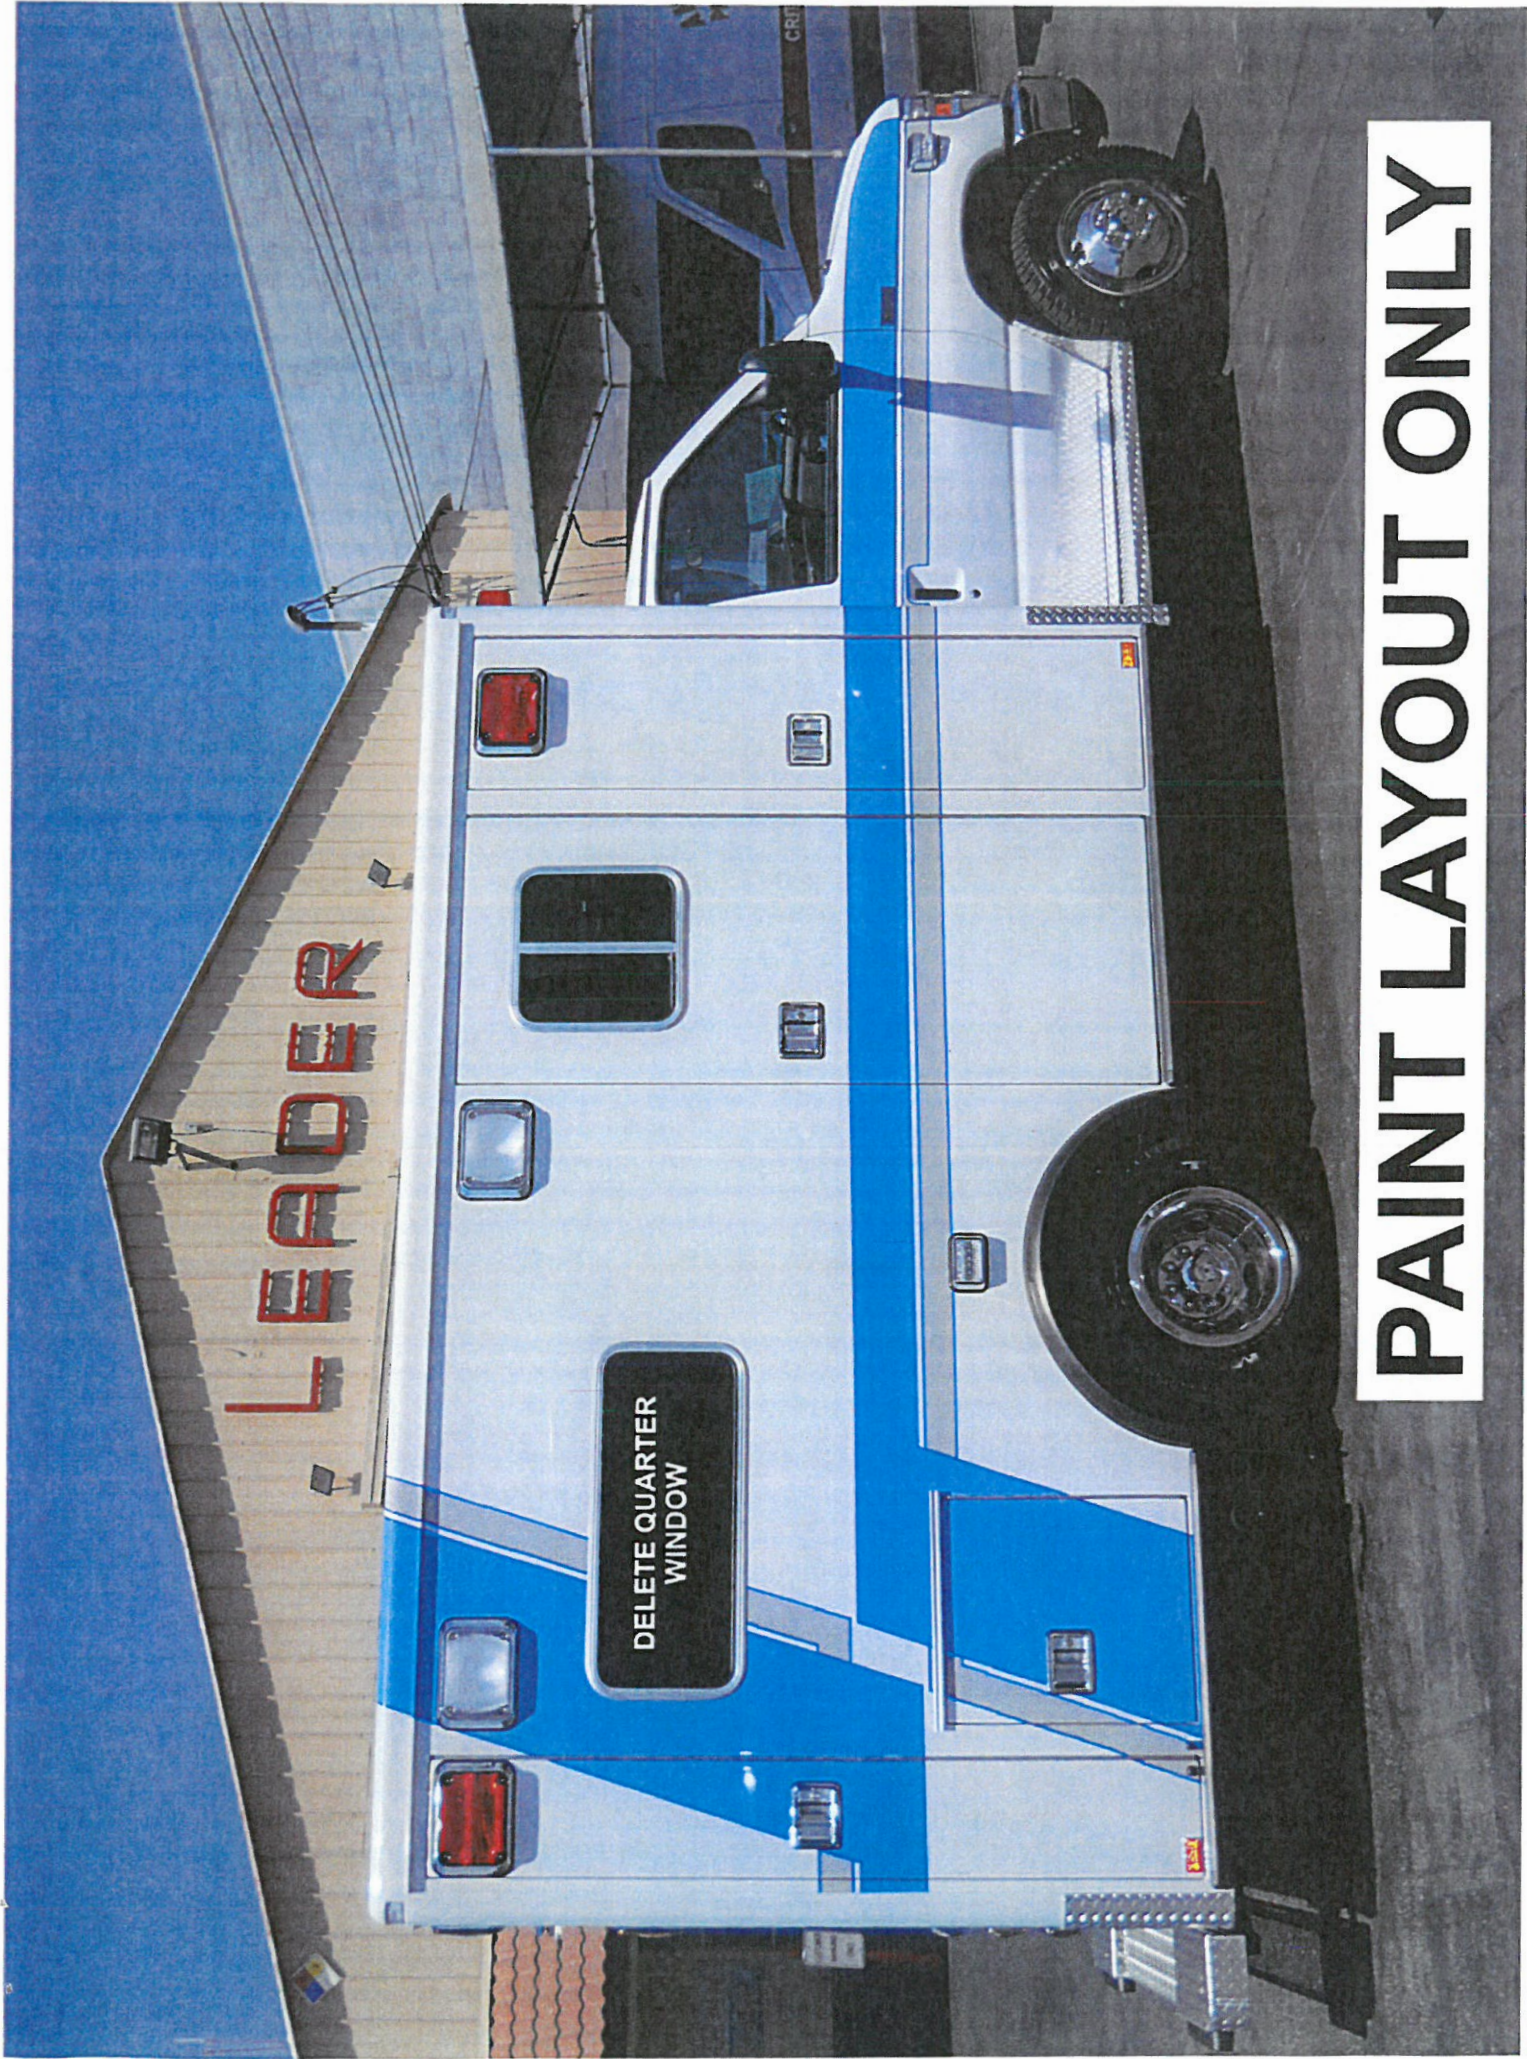

PAINT LAYOUT ONLY



CHEVRONS LAYOUT ONLY

Sales Order

LEADER AMBULANCE Dave Bakey 10941 Weaver Ave So. El Monte, CA 91733	4/12/2016 626-459-5107	Care Ambulance Service 1517 W. Braden Court Orange, Ca 92868 Bill Weston	1790 <i>VIN Number</i> Parent Job 1790
---	-------------------------------	--	---

Itemnumber Description

10 - BASE SECTION

10.

10. 1	Prep modular and misc
10. 51	LI96-148" Ford Type III w/ 72" headroom, Base Conversion
10. 670	(2016) FORD V10 E350 Gas Cutaway Chassis 138" - GVW: 11,500 lbs - Front Axle: 4,600 lbs Twin-I-Beam - Rear Axle: 7,800 lbs - 4.10 Limited Slip Rear Differential - Dual Piston Caliper Brakes, w/ AntiLock and Hydro-Boost - 225-amp HD alternator - 650-CCA / 72 Amp-Hr - Aux 78-amp he, 785 CCA HD Battery - 6.8L Triton V10 Gasoline Engine - 305 HP @ 4,250 RPM / 420 ft.-lb. Torque @ 3,250 RPM - 50-State Emissions Systems - 40 Gallon Fuel Tank - HD Gas-Type Shock Absorbers - .91" Front Stabilizer Bar - 1.125" Rear Stabilizer Bar - 5-Speed TorqShift Transmission w/ Overdrive and In-Tank Oil Cooler - Aux. Transmission Oil Cooler - (6) LT225/75Rx16E BSW All Season Tires - (1) Spare Tire Included - 47A Ambulance Prep Package

20 - PRE TAX

20.

20. 1	Document Processing Fees
20. 110	SPECIAL: Multi Unit Discount (120 Vehicles Built Consecutively) \$2,000 Per Vehicle.
20. 120	SPECIAL: Falck Corporate Fleet Discount : \$7,000 Per Vehicle.

30 - AFTER TAX

30.

30. 50	Factory Rebate(Must supply FIN or K code to qualify) PLEASE NOTE ! FORD OR CHEVY RESERVES THE RIGHT TO REVOKE THESE REBATES AT ANY TIME.
30. 5	(2016) \$6710 FORD FACTORY REBATE (E-350 CUTAWAY)

Dave Bakey
10941 Weaver Ave
So. El Monte, CA 91733

626-459-5107

1517 W. Braden Court
Orange, Ca 92868
Bill WestonVIN Number
Parent Job 1790

Itemnumber Description

40.

51 - CHASSIS ITEMS OPTIONS

51.

51. 100 SPECIAL:
Ford Extracare Service Plan
60 MONTHS/200,000 MILES/8,000 ENGINE HOURS/\$100.00 Deductible

60 - MODULAR BODY ITEMS - STANDARD

60.

60. 1 Modular Dimensions: 96" wide x 148" long x 72" Headroom
60. 2 The module body shall be constructed to provide a minimum fifteen (15) year warranty.
60. 3 Module body shall have an additional (5) year warranty when remounted by an approved remount facility.
60. 4 The corner post shall be extruded aluminum (6063-T5 alloy).
60. 5 The roof corners shall be extruded aluminum (6063-T6 alloy).
60. 6 The exterior wall and roof tubes shall be min (2) inch square with min .125 wall thickness, located on twelve (12) inch centers.
60. 7 In addition to the vertical wall supports there shall be a horizontal beam, located in the beltline area.
60. 8 Gusset supports shall be provided.
60. 9 The exterior body panels shall be 5052-H32 alloy.
60. 10 The thickness required for exterior body panels is:
-Side, front, and rear walls: .125
-Roof and Floor panels: .090
60. 11 Floors shall be aluminum beams covered by aluminum sheeting, then 3/4 inch plywood.
60. 12 All exterior aluminum body panels shall be attached to the structural supports via high performance polyurethane two sided tape.
60. 13 Each body panel shall be welded to horizontal frame members, roof extrusions, and vertical corner posts.
60. 14 The door skin and edges shall be formed from a single sheet of aluminum
60. 15 Outer Door panels are aluminum .125 aluminum.
60. 16 Each door shall include an internal extrusion for added reinforcement.
60. 17 An inner door pan shall fit flush with the inner edges of the door.
60. 18 All module doors shall incorporate an extruded rubber seal located around the perimeter of the door.
60. 19 All doors shall have full-length stainless steel hinges.
60. 20 All doorjamb must incorporate an extrusion that is overlaid by the body skin.

Itemnumber Description

60. 21	Side door and compartment doors shall have gas-filled hold opens. Rear doors shall have grabber style devices.
60. 22	The entire exterior handle assembly shall be Tri/Mark Series 2200 cast metal that is chrome plated and buffed to a high luster.
60. 23	Rear entrance doors shall be equipped with manual safety release latches at top and bottom of doors.
60. 24	Must have full seat travel in the cab. A minimum 6" recess shall be designed into the front bulk head wall of the module body to accomplish this.
60. 25	A minimum of (5) five Mounting platforms shall be attached along the chassis frame rail for a total of (10) ten.
60. 26	Each of the module body access doors shall include window cut-outs.
60. 27	Stainless steel splash shields installed on the lower front face of the module body just aft of the cab access doors.
60. 28	Polished stainless steel fender flares installed around each wheel well opening. Note: See Item #61.20
60. 29	Polished stainless lower body rub rails installed on each side of the module body. Note: See Item #61.20
60. 30	Aluminum Drip Rails, mounted over exterior compartments and access doors.
60. 31	Rear kick plate made out of polished aluminum Diamond plate
60. 32	(4) Aluminum diamond plate corner caps - 14" high

61 - MODULE ITEMS - OPTIONS

61.

61. 20	Rubber fenders & rub rails ILO Stainless Steel. Note: Re-locate rubber rub rails to lower section of body , customer requested that the rub rails not hang below the body. Use "L" type brackets.
61. 500	SPECIAL: COT MOUNT REINFORCEMENT PLATES : Additional under floor reinforcement for Stryker Power Loader (HEV)

67 - EXTERIOR COMPARTMENTS - STANDARD

67.

67. 1	All exterior compartments will be constructed out of polished aluminum diamond plate
67. 2	M1-STREETSIDE FRONT COMPARTMENT This area shall be accessed through a single outside hinged door. The compartment shall house the vehicles primary O2 cylinder. The compartment shall be vented to the outside. Vertical track for mounting of a QRM-V O2 bottle mount shall be welded on the wall of the compartment (See drawings for compartment sizes) Note: Stryker Stair Chair to be stored inside this compartment next to the oxygen bottle , secure stair chair w/ (1) 2" Black Seat Belt strap & 2" footman loops.

Dave Bakey
10941 Weaver Ave
So. El Monte, CA 91733

626-459-5107

1517 W. Braden Court
Orange, Ca 92868
Bill WestonVIN Number
Parent Job 1790

Itemnumber Description

67. 3 M2-STREETSIDE INTERMEDIATE COMPARTMENT
This area shall be accessed through a single hinged door
This compartment shall have (1) adjustable shelf.
This compartment will house vacuum pump, and optional inverter.
(See drawings for compartment sizes)
Note: See Item #68.260
67. 4 M3-STREETSIDE REAR COMPARTMENT
This area shall be accessed through a single hinged door
This compartment will house spare tire and changing tools
(This compartment will have a 3" drop pan)
(See drawings for compartment sizes)
Note: See Item #68.370
67. 5 M4-CURBSIDE REAR COMPARTMENT
This area shall be accessed through a single hinged door
This compartment will house backboards
Add 2" velcro straps to secure backboards
(See drawings for compartment sizes)
67. 6 M5-CURBSIDE INTERMEDIATE COMPARTMENT
This area shall be accessed through a single hinged door, w/ (1) aluminum battery tray w/ 300lb Accuride slides.
(See drawings for compartment sizes)
Note: See Item #68.550
67. 7 M6-CURBSIDE FRONT COMPARTMENT
The upper area shall also be accessible from the vehicle interior front ALS area
This area shall be accessed through a single hinged door
(See drawings for compartment sizes)

68 - EXTERIOR COMPARTMENTS - OPTIONS

68.

68. 100 STREETSIDE MOST FORWARD COMPARTMENT:

68. 130 Add an adjustable shelf

68. 170 SPECIAL:

(2) Chrome "J" Hooks located below shelf, on #1 wall.

68. 200 STREETSIDE INTERMEDIATE COMPARTMENT:

68. 260 SPECIAL:

Install a metal mesh removable cover to protect inverter , battery charger , vacuum pump.

68. 300 STREETSIDE MOST REARWARD COMPARTMENT:

68. 370 SPECIAL:

**MODIFY DEPTH:
Depth needs to be 11"
(HEV)**

68. 500 CURBSIDE INTERMEDIATE COMPARTMENT:

68. 550 SPECIAL:

**To have different key # for this latch only, Key #TM2002
(HEV)****69 - CHASSIS - MODULAR MODIFICATIONS @ LEADER - STANDARD**

Dave Bakey
10941 Weaver Ave
So. El Monte, CA 91733

626-459-5107

1517 W. Braden Court
Orange, Ca 92868
Bill Weston

VIN Number

Parent Job 1790

Itemnumber Description

69.	
69. 1	All exterior compartments shall have black rubber matting on compartment bottoms and shelves
69. 2	Interior LED Lighting in all exterior compartments with the exception of the M5 battery compartment, (2) verticle LED strip lights from top to bottom located on backside of door jam.
69. 3	Cab Running Boards, polished aluminum diamond plate w/ star punched safety grip running boards with mud flap.
69. 4	Recessed license plate holder (Cast Product) w/ LED light (See Print for Location)
69. 5	Install individual rear mud flaps behind each set of rear wheels.
69. 6	All patient compartment entry doors shall have red reflectors in the lower corner (interior)
69. 7	Exterior of modular shall have rectangular reflectors, amber in the lower corners in front, red in lower corners in rear
69. 8	Power activated door locks installed on patient compartment access doors, activated by cab (OEM) door lock switches, and patient comp. access door lock switches - mounted in bezels Note: See Item #7110
69. 9	Stainless steel DOT approved wheel inserts shall be installed on all four outside wheels of the chassis.
69. 10	Stainless steel filler extensions will be installed on rear wheels. Note: DELETE
69. 11	Install (2) tow hooks under rear of vehicle, attach to bumper frame Note: DELETE
69. 12	The rear of the vehicle shall be equipped with a (Docking) step/bumper assembly. The center section of the rear step bumper shall be constructed of aluminum w/ star punched safety grip, and hinged to assist in patient loading.
69. 13	Install Fixed windows in the (2) rear patient access doors, and (1) sliding window in side access door. All (3) windows shall feature a dark privacy tint

70.

200 - INTERIOR CABINETS - STANDARD

A.

A. 1	A1: Streetside lower cabinet, exterior Stainless Steel riser, (1) storage area w/ sliding polycarbonate doors, CPR section w/ storage below w/ hinged lid & hold open gas strut w/ FlexDraw hold down latch, w/ Gibraltar counter top Note: See Item #2200
A. 2	A2: Streetside upper rear cabinet, (2) storage areas w/ sliding polycarbonate doors, w/ adjustable shelves. (3) latex glove storage w/ hinged 3/8" polycarbonate door, (1) hand sanitizer dispenser. Note: See Item #2210
A. 3	A3: Streetside storage cabinet, (3) storage areas w/ sliding polycarbonate doors w/ adjustable shelves in two upper cabinets. Note: See Item #2220
A. 4	A4: Streetside action wall cabinet, (1) upper storage area w/ sliding polycarbonate doors, (1) adjustable shelf, (1) locking drug compartment w/ hinged door and 7/8" lock. Cut out on wall for SSGOR panel. Note: See Item #2230

Itemnumber Description

A. 5	A5: Streetside CPR rear wall.
A. 6	A6: Streetside forward wall/driver side partition with upper A/C removable panel, and opening for oxygen access with hinged plexiglass door. Note: See Item #2240
A. 7	A7: Bulkhead overhead electrical storage cabinet, (1) hinged wood door w/ locking latch Note: Allow 12" x 12" space for Logic 5000 - See Print
A. 8	A8: Partition door, sliding (clear) plexiglass window, hinge door on passenger side, door will swing into module Note: See Item #2250
A. 9	A9: Curbside bulkhead cabinet ALS w/ exterior access, split cabinet with fixed center shelf, upper section w/ (2) hinged 3/8" smoke polycarbonate doors w/ plastic "D" ring latches, (1) adjustable shelf w/ aluminum lip. Lower section w/ (2) hinged wood doors w/ locking latches, (1) adjustable shelf w/ aluminum lip Note: See Item #2260
A. 10	A10: Curbside squad bench w/ (Kendall 5qt.) sharps container and waste container with a single hinged Red polycarbonate lid w/ aluminum edge handle, both located at head end of squad bench. Exterior Stainless Steel riser, (2) hinged lids w/ hold open gas struts and Southco rubber "FlexDraw" hold down latches, NOTE: Include (1) Sharps & (1) Trash container Note: See Item #2270
A. 11	A11: Cabinet over squad bench, divided into two sections w/ hinged (flip up) 3/8" polycarbonate doors w/ plastic "D" ring latches Note: See Item #2280
A. 12	A12: Center Console, (2) side vents, removable face. Directly behind console is a separate removable map box w/ (2) cup holders, polycarbonate dividers, (2) dual 12 volt USB port. Laminate Color: Dark Grey #10592 Note: See Item #2290
A. 13	A13: Action wall panel, exterior laminate carbon fiber, cut outs for O2 outlets, Time Manager, 110V, 12V, volume control outlets Note: See Item #2300
A. 14	A14: Gibraltar "Liquid Stop" mounted on floor in walkthrough, between cab & modular
A. 15	A15: Modular headliner to be 1/4" MDF laminated.
A. 16	A16: Misc. Wood Material - Seat Cushions, Back rests, Head rests, CPR head bumpers, CPR side bumpers, Curbside wall, head bumpers, fillers, wood sub-floor, A/C Styrene Board

2000 - INTERIOR CABINETS - OPTIONS

A. 2000	
A. 2200	SPECIAL: Note: CUSTOM A1 CABINET - SEE PRINT 1) Delete Gibraltar counter top 2) Replace Gibraltar with Stainless Steel 18 gage w/ trim lock on flange edge. 3) Add hinged tip out trash compartment @ rear on face 4) Add (3) Glove Box storage "SE" style next to trash compartment. 5) Stainless Steel Riser
A. 2210	SPECIAL: Note: CUSTOM A2 CABINET - SEE PRINT 1) Install a Black 2" cargo net w/ Mesh sewn to the back side w / (3) METAL quick connect clips @ top w footman loops @ bottom. 2) Compartment to be open with (2) adjustable shelves
A. 2220	SPECIAL:

Dave Bakey
10941 Weaver Ave
So. El Monte, CA 91733

626-459-5107

1517 W. Braden Court
Orange, Ca 92868
Bill WestonVIN Number
Parent Job 1790

Itemnumber Description

Note: CUSTOM A3 CABINET - SEE PRINT

- 1) Delete center storage compartment
- 2) Center section to remain open
- 3) Add 18 gage Stainless Steel tray to center section w / trim lock on flange edge .

A. 2230 SPECIAL:

CUSTOM A4 CABINET - SEE PRINT

- 1) Delete adjustable shelf in upper compartment
- 2) Relocate locking drug compartment to action wall panel
- 3) See Print for cut-outs

A. 2240 SPECIAL:

CUSTOM A6 CABINET - SEE PRINT**Enlarge oxygen access opening .**

A. 2250 SPECIAL:

CUSTOM A8 DOOR - SEE PRINT**Reduce the length of door due to drawers below .**

A. 2260 SPECIAL:

Note: CUSTOM A9 CABINET - SEE PRINT

- 1) Delete hinged plexiglass & wood doors
 - 2) Install (3) adjustable shelves and (1) "fixed upper shelf w / removable rubber mat
 - 3) Install below scanner compartment a Black 2" cargo net w / Mesh sewn to the back side w / (3) METAL quick connect clips @ top with footman loops @ bottom.
 - 4) Upper shelf to be "fixed" and set 17" down, delete lip on front edge , and enclose the curbside so no access will be available from exterior compartment . (This area is for Scanner storage)
- See Print**

A. 2270 SPECIAL:

Note: CUSTOM A10 CABINET - SEE PRINT

- 1) Top drop sharps and trash compartments w / hinged aluminum powder coated Red lid @ head of squad bench and they need to be the same height as squad bench cushion to allow backboard to lay flat
- 2) A seperate Stainless Steel (3) oxygen bottle holder @ head of squad bench
- 3) Stainless Steel Riser
- 4) NOTE: The Cargo Net will mount inbetween the sharps and oxygen cabinets

A. 2280 SPECIAL:

Note: CUSTOM A11 CABINET - SEE PRINT

- 1) Delete flip up plexiglass door
- 2) Add sliding plexiglass doors ILOS

A. 2290 SPECIAL:

Note: CUSTOM A12 CABINET - SEE PRINT

- 1) Cut holes for two-way radios.
- 2) Fasten removable lid down using 10/32 machine screws into nut certs .

A. 2300 SPECIAL:

Note: CUSTOM A13 CABINET - SEE PRINT

- 1) Action wall panel to incorporate locking drug box w / 7/8" drawer lock
- 2) Two-way radio cut out
- 3) See Print for layout & cut outs

A. 2310 SPECIAL:

Note: ALUMINUM DRAWERS (2) - SEE PRINT

- 1) Supply (2) aluminum drawers w / full drawer extensions , w / aluminum faces laminated in Gloss White finish, with chrome "D" ring locking latches.
- 2) Supply an 18 gage Stainless Steel tray w / 1" flange located on top of drawers - add trim lock to flange edge, with removable rubber mat inside S / S tray.

300 - INTERIOR TRIM AND COLOR - STANDARD

Dave Bakey
10941 Weaver Ave
So. El Monte, CA 91733

626-459-5107

1517 W. Braden Court
Orange, Ca 92868
Bill Weston

VIN Number

Parent Job 1790

Itemnumber Description

B.

- | | |
|-------|--|
| B. 1 | Floor color/material - (Coved), Anti-Microbial, UV Protected, Lonseal - Loncoin II Flecks Sapphire #152UV (Blue) |
| B. 2 | Gimp, Headbumpers, Fillers, upholstery color/material - Blue Academy Independence #IND-8601 (L#05-077) w/ 1/4" closed cell foam. |
| B. 3 | Laminate color, patient compartment, exterior & interior cabinets, Gloss White #D354-F1 Wilsonart |
| B. 4 | Laminate color, patient compartment headliner, Gloss White #D354-F1 Wilsonart |
| B. 5 | Laminate color, action wall panel, Carbon Fiber |
| B. 6 | Polycarbonate color .240, tinted |
| B. 7 | (3) Seat Cushions, (3) Back Rests, (2) Head Rests, (2) CPR Side Bumpers, (3) CPR Head Bumpers - "Water Fall" style, 2" foam, velcro fasteners.
Note: See Item #3200 |
| B. 8 | Attendant Seat High Back (Wise); 6 degree, medium density foam, 3 point seat belt, sewn w/ Leader logo, w/ swivel base;
Color: Blue Academy Independence (Leader Supplied L#05-077)
Logo: Red & white
Note: See Item #3130 |
| B. 9 | Counter Top Color, Indigo Melange #9027ML - Gibraltar Material
Note: See Item #2200 |
| B. 10 | Door panels (3) are to be aluminum covered with #D354-F1 Gloss White laminate, w/ 6" 3M Blue Diamond Grade #DG3#4095 reflective safety stripe, w/ stainless steel @ bottom of panels. |
| B. 11 | Polycarbonate sliding doors, retain handles on doors and provide holes for cable ties. |
| B. 12 | The patient area of the vehicle shall be insulated w/ 2" Owens Corning Quiet R, glass fibers, fire resistant, fungi & bacteria resistance, for both thermal and acoustic insulation |

3000 - INTERIOR TRIM AND COLOR - OPTIONS**B. 3000**

- | | |
|---------|--|
| B. 3130 | Attendant seat WISE 6 degree high back w/ built in child seat, w/ armrests. ILOS, NOTE: This is not available in vacuum form, will be "Sewn"
Note:
1) Vinyl Color: Blue Academy Independence (Leader supplied L#05-077), w/ CARE Logo embroidered in seat back.
2) Seat to slide front to rear only , not swivel. Add bolt or remove lever to prevent swivel . |
| B. 3200 | SPECIAL: |

CARE Logo embroidered in squad bench head rests .

400 - WARNING DEVICES - STANDARD**C.**

- | | |
|------|---|
| C. 1 | Warning lights, front of upper module ILO lightbar, (7) total, Whelen 900 Super LED, (5) Red w/ Red lens, (2) White w/ Clear lens. Center light to be steady burning. Chrome flanges included.
"R" - "W" - "R" - "R" - "R" - "W" - "R" |
|------|---|

Dave Bakey
10941 Weaver Ave
So. El Monte, CA 91733

626-459-5107

1517 W. Braden Court
Orange, Ca 92868
Bill Weston

VIN Number

Parent Job 1790

Itemnumber Description

C. 2	Warning lights, rear of vehicle, upper outboard corners, (2) Whelen 900 Super LED Red w/ Red lens. Chrome flanges included.
C. 3	Warning lights, side, (4) Total, (2) per side, Whelen 900 Super LED Red w/ Red lens. Chrome flanges included.
C. 4	Warning lights grille, (2) Whelen LIN3 Super LED Red w/ Clear lens & Chrome Housing. Mounted on upper horizontal grille bar. Note: See Item #4510
C. 5	Warning lights, rear of vehicle, window level, (2) Whelen 900 Super LED Amber w/ Amber lens. Chrome flanges included.
C. 6	Intersection lights, front fenders, (2) Whelen 700 Super LED Red w/ Red lens. Chrome flanges included. Note: See Item #4520
C. 7	Headlight flasher, Leader solid state, electronic, console switch.
C. 8	Siren speakers, (2) Gast Products 100 watt siren speakers, recessed through front OEM bumper. (Polished Aluminum Finish) Note: See Item #4530
C. 9	Scene lights, side, (4) total, (2) per side, Whelen 900 Halogen w/ Clear lens. Chrome flanges included.
C. 10	Scene lights, rear, (2) Whelen 700 Halogen w/ Clear lens. Chrome flanges included.
C. 11	Running board lights, (2) Whelen #20C0CDCD LED, (1) per side mounted in splash shield, activate via cab doors, constant hot.
C. 12	Front, rear, side, FMVSS LED marker lights w/ Chrome housings. Front; (5) Amber lights Rear; (5) Red lights Side @ Rear (2) Red lights
C. 13	Back-up, turn and stop/tail lights, Whelen 600 LED w/ Chrome flanges shall be as follows: (2) Turn Signal Lights, Whelen 600 LED Amber w/ Amber lens w/ arrow - outboard on diamond plate. (2) Stop/Tail Lights, Whelen 600 LED Red w/ Red lens - inboard on diamond plate. (2) Back-Up Lights, Whelen 600 LED White w/ Clear lens - above diamond plate on body. Note: See Item #4540
C. 14	Brake light, rear upper center, Kinequip LED Red, w/ Red lens. Note: See Item #4570
C. 15	Back-up alarm, rear mounted, 97 decibel with auto reset, console defeat switch
C. 16	Warning light flasher (2) Vanner #3250 GCPE
C. 17	Siren electronic, located in overhead console, Whelen dual tone 295HFSA7 w/ remote amp GA spec, (hi-lo deleted) 100 watt output w/removable mic, hands free horn ring control. Note: See Item #4550

4000 - WARNING DEVICES - OPTIONS

C. 4000	
C. 4510	SPECIAL: Note: Grille Lights, Whelen TIR6 500 Red Super LED w/ Chrome Housings - ILOS
C. 4520	SPECIAL: Note: Intersection Lights, (4) Whelen #40C02ZCR 400 White w/ Clear lenses & Chrome flanges. (2) Front Fenders (2) Rear, over rear wheel well

Itemnumber Description

C. 4530 SPECIAL:

Note: Siren speaker, under bumper mount, (2) 100 watt drivers.

C. 4540 SPECIAL:

Relocate, refer to prints for new location .

C. 4550 SPECIAL:

Note:**Siren Electronic, Whelen Dual Amp 295HFS2X (w/out mic) ILOS****NOTE: Activate via Primary/Secondary switch in Primary mode only .****NOTE: California Spec, Hi-Lo Deleted**

C. 4560 SPECIAL:

Note: Grille Lights Vertical:**Whelen LED verticle strip lights , mounted on front OEM grille , Red w/ Clear Lenses.**

C. 4570 SPECIAL:

Note: Whelen 700 Red LED w/ Chrome Flange ILOS .

C. 4580 SPECIAL:

All LED lights to Triple Flash .**500 - ELECTRICAL CONTROL CENTER - STANDARD**

D.

D. 1 Bulkhead electrical component storage cabinet, fuse bar, fuse bar bracket, terminal blocks, etc.

D. 2 Overhead console, fiberglass (Grey) overhead console to house switches, siren, indicator lights.

D. 3 Electrical Switch Panel, front overhead console, Santex (Carbon Fiber Finish), back lit w/ blank legends.

D. 5 Voltage meter analog, located in overhead conole, TST 0-18 volts.

D. 6 Amperage meter analog, located in overhead console, TST with remote induction sensor - no shunt.

D. 7 Indicator lamp Green, MASTER ON, C.H. LED pilot light.

D. 8 Indicator lamp Red, EMERG START, C.H. LED pilot light.

D. 9 Indicator lamp Red, DOOR OPEN, C.H. LED pilot light, includes all door switches for exterior compartments and patient access doors.

D. 10 Indicator lamp Red, PARKING BRAKE, C.H. LED pilot light, w/ audible buzzer.

D. 11 Switch, PRI. SEC, C.H. LED, lit Red/Amber, center off, primary controls all emergency lights, secondary controls rear Amber warning lights only.

Note:**Primary - All Emergency Lights****Secondary - (4) Rear Warning Lights**

D. 12 Switch, HEADLIGHT FLASHER, C.H. LED, lit White.

D. 13 Switch, BACK-UP ALARM, C.H., (non lit) momentary.

D. 14 Switch, LEFT FLOOD, C.H. LED, lit White.

D. 15 Switch, REAR FLOOD, C.H. LED, lit White.

D. 16 Switch, RIGHT FLOOD, C.H. LED, lit White.

Dave Bakey
10941 Weaver Ave
So. El Monte, CA 91733

626-459-5107

1517 W. Braden Court
Orange, Ca 92868
Bill WestonVIN Number
Parent Job 1790

Itemnumber Description

- D. 17 Switch, PATIENT DOME, 3-way, C.H. LED, lit Amber.
- D. 18 Switch, PATIENT HEAT/AC, 3-way, C.H. LED, lit Blue.
- D. 19 Switch, MODULE DISCONNECT, C.H. LED, lit Green.
- D. 20 Switch, EMERGENCY START, momentary toggle w/switch guard, (non-lit)
Note: See Item #7200
- D. 21 Map lights, (2) dual Red/White LED map lights located in cab overhead console, (1) above driver, (1) above passenger.
- D. 22 ~~400,000 CP Spot light, black rubber, halogen Clear, hard wired. (clip supplied loose)~~
Note: DELETE
- D. 23 Two-way radio power, Positive-Negative-Ignition, with terminal strip, located inside center console.

5000 - ELECTRICAL CONTROL CENTER - OPTIONS

- D. 5000
- D. 5030 Anti-theft device, ignition controlled, Leader.

600 - ELECTRICAL PATIENT COMPARTMENT - STANDARD

E.

- E. 1 Dome lamps, ceiling, (8) flush mount, Whelen LED High - Low Dome Lights. Door jamb switch activated (low intensity) and switch panel activated (high-low)
- E. 2 Electrical outlet 12 volt, Blue Sea #1011, Two (2) cigarette lighter style.
Location:
(1) Rear action wall
(1) ALS cabinet
Note: Delete ALS outlet.
(1) Only on action wall.
- E. 3 Electrical outlet 12 volt, Blue Sea #1016, Three (3) Dual USB Port.
Location:
(2) Center console
(1) Action wall area
- E. 4 Electrical outlet 120V, (2) Two, (1) on ALS cabinet, (1) on action wall, with pilot lights, mounted on grey plastic housings, wired to shore power.
Note: See Item #6060
- E. 5 Switch plate rear, (10) position Santex (Carbon Fiber Finish) back lit w/ blank legends.
- E. 6 Switch, DOME, 3-way, C.H. LED, lit Amber.
- E. 7 Switch, DOME HI-LO, C.H. (non lit)
- E. 8 ~~Switch, ELECT SUCTION, C.H. LED, lit Amber.~~
Note: DELETE
- E. 9 Switch, EXHAUST, C.H. LED, lit Amber.
- E. 10 Switch, PATIENT HEAT A/C, 3-way, C.H. LED, lit Blue.
- E. 11 Switch, A/C, FAN HI-LO, C.H. (non-lit)

Dave Bakey
10941 Weaver Ave
So. El Monte, CA 91733

626-459-5107

1517 W. Braden Court
Orange, Ca 92868
Bill WestonVIN Number
Parent Job 1790

Itemnumber Description

E. 12	Switch, A/C, HEAT-COOL, C.H. (non-lit)
E. 13	Switch, COMPARTMENT LIGHTS, C.H. LED, lit White.
E. 14	Switch defeat, PATIENT DOME, side and rear door, C.H. (not lit) Note: DELETE
E. 15	Switch defeat, RIGHT FLOOD, C.H. (non lit) Note: DELETE
E. 16	Switch defeat, REAR FLOOD, C.H. (non lit) Note: DELETE
E. 17	Switch plate, (Defeat Switches) (2) position Santex (Carbon Fiber Finish) Note: DELETE
E. 18	Radio rear volume control for AM/FM, action wall area. See print for location. Note: DELETE
E. 19	AM-FM Speakers (2) above rear access doors in patient compartment Note: DELETE
E. 20	Shore power, 120V, 15 amp, behind driver door, Hubbell cast cover, wired to 110V outlets in patient compartment.
E. 21	Restocking light time, squad bench wall @ head end, five minute, controls (4) dome lights over cot (high intensity) Note: 15 Minute Restocking Timer ILOS Timer to activate (2) rear, and (2) front dome lights . (See Prints for detail)
E. 22	Glock, Emergency Time Manager, mounted in action wall panel, chimes. Note: Delete
E. 23	Interior cabinet lighting, LED strip lighting inside compartments including below action wall panel, activated w/ lit switch in action wall Note: Delete
E. 24	Step Well Light LED, located in side door step well, door switch activated,
E. 25	Inverter Pre-Wire, Includes 12 volt Pos-Neg with Anderson quick disconnect connector, terminating inside M2 exterior compartment. (Does not include remote panel or rocker switch)

6000 - ELECTRICAL PATIENT COMPARTMENT - OPTIONS

E. 6000	
E. 6010	Battery charger, IOTA 45 amp, (connected to shoreline). Note: Note: IOTA charger will charge the Starting / Emergency Start batteries only . Both the Inverter and the IOTA battery chargers are wired to the same Shoreline inlet . Locate inside M2 compartment.
E. 6030	Power inverter and battery charger - Xantrex, Freedom, HW-1000W, w/auto transfer, (connected to electrical outlets and shoreline). Note: Battery Charger from Inverter will charge (2) Two-Way Radio Batteries Only . Locate inside M2 compartment. Both the Inverter and the IOTA battery chargers are wired to the same Shoreline inlet.
E. 6060	Electrical outlets 120V, additional location, (location on print), pilot light, stainless steel, tie in to 120 circuit, (in addition to standard). Note: Note: (2) Additional 110V Outlets: - (1) located in action wall next to standard 110 outlet. - (1) located behind squad bench on wall . (See Prints for detail)

Dave Bakey
10941 Weaver Ave
So. El Monte, CA 91733

626-459-5107

1517 W. Braden Court
Orange, Ca 92868
Bill Weston

VIN Number
Parent Job 1790

Itemnumber Description

E. 6300 SPECIAL:

Install (2) LED "Puck" lights inside A9 Scanner cabinet, activated via Ignition switch .
See Prints

E. 6310 SPECIAL:

PRE-WIRE FOR EPCR & ROAD SAFETY ANTENNA:
Per Andrew Garcia :

(SCANNER) Leader to run a CAT 5 cable (Leader Supplied) and a 12 gage Red and 12 gage Black set of wires from the Electrical Compartment (A7) to the Scanner cabinet in patient compartment , leave approx 24 inches extra on both ends . Scanner cabinet will need a hole w / grommet in the upper corner to allow wiring into compartment , add split loom to wiring inside scanner cabinet .

(GPS LOGIC MODEM) Leader to run #8724 Beldon cable (Radio Shop Supplied) from Electrical Compartment (A7) to the empty OEM compartment under the passenger seat , with approx. 3 ft. of slack coiled up at both ends .

(ROAD SAFETY) Leader to run a CAT 5 cable (Leader Supplied) from Electrical Compartment (A7) to the empty OEM compartment under the passenger seat , with approx. 3 ft. of slack coiled up at both ends .

(GPS LOGIC) Leader to run a CAT 5 cable (Leader Supplied) from Electrical Compartment (A7) with approx. 3 ft. of slack, to behind the passenger seat , with approx. 15 ft. of slack coiled up .

(STEREO TRIGGER WIRE) Leader to run a 16 gage wire tagged as "STEREO TRIGGER" from Electrical Compartment (A7) to OEM Stereo area in dash , w/ approx. 3 ft. of slack coiled up at both ends

(VIDEO CABLE) Leader to install (Atlas Lab Supplied) a 15 foot Video cable running from Center Console to OEM Stereo area in dash .

NOTE: The RCA end of cable to dash and BNC end to center console .

NOTE: Wire only Radio Service will do final connections .

E. 6320 SPECIAL:

Supply 12V. Positive - Negative for Scanner located in A 9 cabinet.
Protected with 20 amp circuit breaker.

E. 6330 SPECIAL:

Action Wall Work Light:
Add LED Strip light to bottom of action wall panel . Activated via Lit White rocker switch labled "WORK LIGHT"
See Print

700 - ELECTRICAL AND MECHANICAL - STANDARD**F.**

F. 1 Air conditioning/heater, driver compartment switching control dash, OEM, w/prep for rear air.

F. 2 Air conditioning/heater, patient compartment, ducted central air, with intake vent, and (6) A/C round louvers.

F. 3 Air conditioning hose, shielded low loss, wedged on fittings, R134 (included w/ F2)

F. 4 Heater hose, Nomex, Ford QVM (included w/ F2)

F. 5 Tri-Battery system - (2) primary, and (1) emergency start, redundant battery system wiring and electrical components. Overhead console mounted LED Red indicator lamp and activation switch. Includes (1) battery under hood in OEM location, and (2) 65 series batteries located in battery box.

Note: See Item #7200

Dave Bakey
10941 Weaver Ave
So. El Monte, CA 91733

626-459-5107

1517 W. Braden Court
Orange, Ca 92868
Bill WestonVIN Number
Parent Job 1790

Itemnumber Description

F. 6	Shut Down Timer, with 5 min. delay activated via ignition switch. Note: Set timer to 15 minutes.
F. 7	Wiring loom, Leader fabricated, hi temp SXL, color coded, number coded and function labeled, with split loom wire protection
F. 8	Antenna wiring (2) RG58A/U coax, roof location # 1 & 2 with Stainless Steel (Interior) access plates, terminate in cab, inside center console. Note: #1 Antenna, Customer Supplied Penta -Band (5 coax cables combined in one antenna) Terminate all (5) inside electrical compartment located in patient compartment . See Item #7210
F. 9	Power Exhaust vent, left rear, Cast Products exterior cover, interior louver round
F. 10	Remote door lock release, front grille. NOTE: Installation of Remote Door Lock Switch feature may increase the likelihood of unauthorized entry into vehicle. With this feature, purchaser further agrees to hold Leader Ind. or chassis manufacture harmless for any loss of vehicle of contents caused by unlawful access. (Customer has the option to Delete this feature) Note: Relocate to rear license plate holder . See Print
F. 11	Reverse activated (rear) loading lights
F. 12	Auto Throttle (Gas Engine), In-Power #DBT-LD (Ford QVM Approved)

7000 - ELECTRICAL AND MECHANICAL - OPTIONS**F. 7000**

F. 7061	Pre - Wire for Road Safety "New" 4000 System. Includes wire harness, Receiver with speaker. Vehicle antenna and Spotter Switch Kit. (NO Connections Made)
---------	--

Dave Bakey
10941 Weaver Ave
So. El Monte, CA 91733

626-459-5107

1517 W. Braden Court
Orange, Ca 92868
Bill WestonVIN Number
Parent Job 1790

Itemnumber Description

Note: SPOTTER SWITCHES :

- Install interior spotter switch on a S /S plate located in the patient compartment ceiling @ rear, and the exterior spotter switch mounted above the driver side Brake light .
- Both switches will need to be connected to Spotter Switch Module .

ROAD SAFETY:

- The Road Safety Harness plugs should be ran into the empty OEM compartment under the passenger seat with approx. 2 ft. of slack.
- (1) Speaker - should be installed in the cab where bulkhead meets headliner . This is to be connected to the speaker wire of the road safety harness .
- (3) Black wires should be coiled up in the empty OEM compartment under the passenger seat .
- (1) Red wire should be terminated to a 12-volt constant source with a 5 amp fuse.
- (1) Blue wire should be terminated to a 12-volt Ignition source with a 5 amp fuse.
- (1) Blue/Yellow & (1) Blue/Black wire should be ran and coiled up underneath the steering column .
- (1) Light Green wire & (1) Dark Green wire under driver seat .
- White/Brown wire needs to be connected under driver seat for the Left Turn Signal .
- White/Yellow wire needs to be connected under driver seat for the Right Turn Signal .
- Green/Red wire needs to be connected under driver seat for the Brake Lights .
- Green/Black wire needs to be connected to the Reverse Lights .
- Brown/Red & Gray/Red wires needs to be ran under the Driver Seat coiled up .
- Green/Grey wires need to be connected to the Primary Flashing Lights .
- Brown/Yellow & Grey/Yellow wires need to be connected to the Siren Speaker .
- Install OBD2 wire harness from OEM plug on driver side kick panel to under the passenger seat . (customer will need adapter for Sprinter)
- Install (Blue) internet cable from A 9 electrical cabinet in patient compartment , to under the passenger seat.
- If there are any extra wires in the road safety harness - please leave those coiled up inside the empty OEM compartment under the passenger seat .

AS OF 8-27-15 The "New" 4000 system requires the installation of the supplied antenna . Locate on forward section of modular roof (driver side)

F. 7110 Power door locks for exterior compartment doors. (Except Battery Compartment door).

F. 7200 SPECIAL:

Dave Bakey
10941 Weaver Ave
So. El Monte, CA 91733

626-459-5107

1517 W. Braden Court
Orange, Ca 92868
Bill WestonVIN Number
Parent Job 1790

Itemnumber Description

CARE BATTERY SYSTEM :

Total of (5) Batteries, (4) located in M5 exterior battery compartment , (1) Starting battery to remain in OEM location. Additional components required for this system listed below . See Schematic.
(2) Batteries for Starting & Conversion, (1) OEM Location w/ OEM Battery, (1) M5 Compartment w/ Dek Battery.
(1) Deka Battery for Emergency Start , M5 Compartment.
(2) Deka "Intimidator" Battery for Two-Way Radios, M5 Compartment.

CARE CIRCUIT:

Emergency Start Circuit to be wired w /out locking feature . Emergency Start feature is engaged only while holding the Emergency Start switch in the on position . This will activate the Red indicator lamp and it will stay lit until re-set by replacing the fuse . The standard re-set circuit breaker will not be used , its being replaced with a in -line fuse located inside center console . (To re-set the pilot light you will need to replace the blown fuse)

ADDITIONAL COMPONENTS FOR CHARGING SYSTEM :

(1) Kussmal Controller #091-139-CONT-12
(1) Kussmal Solenoid #091-139-SOL-12HO
(2) Deka "Intimidator" Batteries
(2) Deka Battery
(1) 100 amp Fuse & Holder

NOTE: AS OF 1-22-13 CUSTOMER REQUESTS FOR LEADER TO ADD A 16 GAGE WIRE CONNECTED TO THE E-START INDICATOR LIGHT AND TO TERMINATE IN RADIO COMPARTMENT . (RADIO SHOP WILL MAKE THE FINAL CONNECTION FOR THIS CIRCUIT INSIDE THE RADIO COMPARTMENT)

F. 7210 SPECIAL:

Three Additional Antennas : With S/S (interior) access plates only, NO HOLES IN ROOF
#2 Antenna, Leader Supplied (wire only) terminate inside center console .
#3 Antenna, Leader Supplied (wire only) terminate inside center console .
#4 Antenna, Leader Supplied (wire only) terminate inside center console .

F. 7230 SPECIAL:

Note: Supply (2) sets of Two-Way radio power , 6 gage, Positive w/ 50 amp circuit breaker protection & Negative, plus Ignition w/ terminal strip, clearly identified as Two-Way Radio Power .
Locate: (1) set inside center console
Locate: (1) set inside electrical cabinet in patient compartment

NOTE: Pick up the 12V for this option from the dedicated "DEKA INTIMIDATOR" batteries for radios .

F. 7240 SPECIAL:

Itemnumber Description

**Note: Supply & Install / 4-CHANNEL DIGITAL VIDEO (4) CAMERA SYSTEM
MODEL #MVS-SSD4M ITEMS INCLUDED WITH THIS MODEL # ARE LISTED BELOW :**

(1) MVS-SSD4M Solid State DVR Includes : 4-channel DVR with 4-channels of audio, 100% Solid State Digital memory with H.264 D1 Hi-resolution compression power cable , remote, security case and driver alerts.

(1) MVC-601NIR Color Camera Forward Facing .

(3) MVC-600NIR Color Camera Interior Facing , Side Facing Interior , Exterior Rear.

(4) Camera Cables , 25 foot Camera Cables .

Seven year warranty on DVR and cameras .

MOUNTING INSTRUCTIONS

* (1) Wide angle camera MVC 600NIR (interior) incab facing towards curbside mounted on headliner .

* (1) Wide angle camera MVC 601NIR (interior) incab facing forward thru windshield mounted on headliner, under passenger side sun visor clip .

* (1) Wide angle camera MVC 600NIR (interior) in cab facing rearward towards driver & passenger, mounted on headliner , between both sun visors .

* (1) Weather proof camera MV -600NIR (exterior) located below third brake light .

* (1) Hard drive located inside center console .

F. 7250 SPECIAL:

Install a Kusmaul 7.0 amp Solar Panel on the roof of Modular . Wire to Two-Way Radio batteries only .

800 - OXYGEN SYSTEM - STANDARD

G.

G. 1 Aspirator, action wall area, SSCOR 22000, flush mount panel and gauge.

Note: See Item #8110

G. 2 Vacuum pump, 12V, w/vent tube to exterior. Locate in M2 exterior compartment.

Note: See Item #8110

G. 3 Oxygen system, Amico Ohio style quick release, (3) outlets, (2) in action wall panel, (1) on wall above squad bench @ headend

Note: See Item #8020 & Delete 3rd oxygen outlet above squad bench .

G. 4 ZICO Main O2 Bracket - Locate in M1 exterior compartment. Capable of holding either "M" or "H" tank

Note: Set up for "M" tank

G. 5 Oxygen wrench, fasten cable to wall by oxygen bottle.

8000 - OXYGEN SYSTEM - OPTIONS

G. 8000

G. 8020 Flowmeter Integrated, Amvex 0-15 LPM (Tube Style) Replace (1) Standard Oxygen Faceplate

G. 8040 Oxygen regulator, preset 50 psi.

Note: Fasten regulator to #1 wall (visible through window) with a Leader fabricated mounting bracket , and supply a 3000lb. High Pressure line from regulator to tank .

G. 8110 Aspirator portable, SSCOR model 2310BV-S-CORT VX2.

G. 8400 SPECIAL:

Stainless Steel (3) oxygen bottle holder @ head of squad bench .

NOTE: Cargo Net will need to mount inbetween oxygen and sharps cabinets .

900 - HARDWARE -STANDARD

Dave Bakey
10941 Weaver Ave
So. El Monte, CA 91733

626-459-5107

1517 W. Braden Court
Orange, Ca 92868
Bill WestonVIN Number
Parent Job 1790

Itemnumber Description

H.

- H. 1 Seat belts, (3) Six Point Restraints, (2) for squad bench attendants, (1) for CPR seat attendant, (2) lap restraints for squad bench patient.
- H. 2 I.V. holders, (2) positions, #1 & #3, Cast Products # A20-14 flush mount, polished aluminum.
**Note: Positions 2 & 3
See Print**
- H. 3 (3) Anti-Microbial 1-1/2 inch diameter stainless steel satin finish, angled door handles mounted on module access doors.
Note: Powder Coat - Safety Yellow
- H. 4 Ceiling grab rail Anti-Microbial, center mounted, stainless steel, satin finish 1-1/2 inch diameter, 72 inches in length.
**Note: Replace 72" with 96"
Powder Coat both 96" and 24" - Safety Yellow**
- H. 5 Door sills, (rear), bright stainless steel, w/ramp edge, (side) bright stainless steel sill 1 1/2" x 2 1/2"
- H. 6 Net, Front end of squad bench, 4 anchor fasteners, (1) ratchet, Black 1 1/2" webbing
Note: See Item #8400

H. 9000

1000 -PATIENT HANDLING EQUIPMENT - STANDARD

I.

- I. 1 Cot fastener, Ferne #185 (Short 86") Stat Trac fastening system. (Center Position)
(Compatible with 35A, 35 series, 93 series, and Power Flex Cots, Cots must be upgraded to StatTrac compatibility.)

10000 -PATIENT HANDLING EQUIPMENT - OPTIONS

I. 10000

- I. 10400 SPECIAL:
Install Customer Supplied Stryker Package : (\$37,909)
1) Stryker #6390 Power Load System .
2) Stryker #6506 Power Pro XT Cot
3) Stryker #6252 Stair Chair Pro.

- I. 10410 SPECIAL:
Install Customer Supplied Stryker Power Loader .

1100 -PAINT, BODY AND GRAPHICS - STANDARD

J.

- J. 1 An acrylic urethane paint process is required on the module body.
- J. 2 Emblems, Leader front fenders, rear doors, no smoking labels, ETC.

11000 -PAINT, BODY AND GRAPHICS - OPTIONS

J. 11000

Dave Bakey
10941 Weaver Ave
So. El Monte, CA 91733

626-459-5107

1517 W. Braden Court
Orange, Ca 92868
Bill WestonVIN Number
Parent Job 1790

Itemnumber Description

J. 11070 REAR "CHEVRONS" FLAT REAR SURFACES, INCLUDING DOORS:
Red/Yellow "Chevron" striping, 6" wide in an upside down "V" pattern.
Fluorescent Yellow Green, 3M Diamond Grade Conspicuity #983-23
Electro Cut Red Translucent 3M #1172

J. 11200 SPECIAL:

Note: Paint Stripes (2) Colors w/ Pin Stripe

- Sierra Blue FLNA #5203
- Sterling Silver BMW7103

- Pin Stripe 1/4" Blue Reflective 3M#680CR-75 around both paint stripes .

- NO PAINT ON REAR, "CHEVRONS" WILL BE INSTALLED

- See Print for Layout

- (65) - (540)
